



PHOTO 1



PHOTO 2


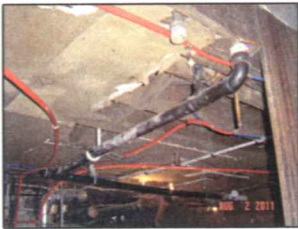



PHOTO 3



PHOTO 4

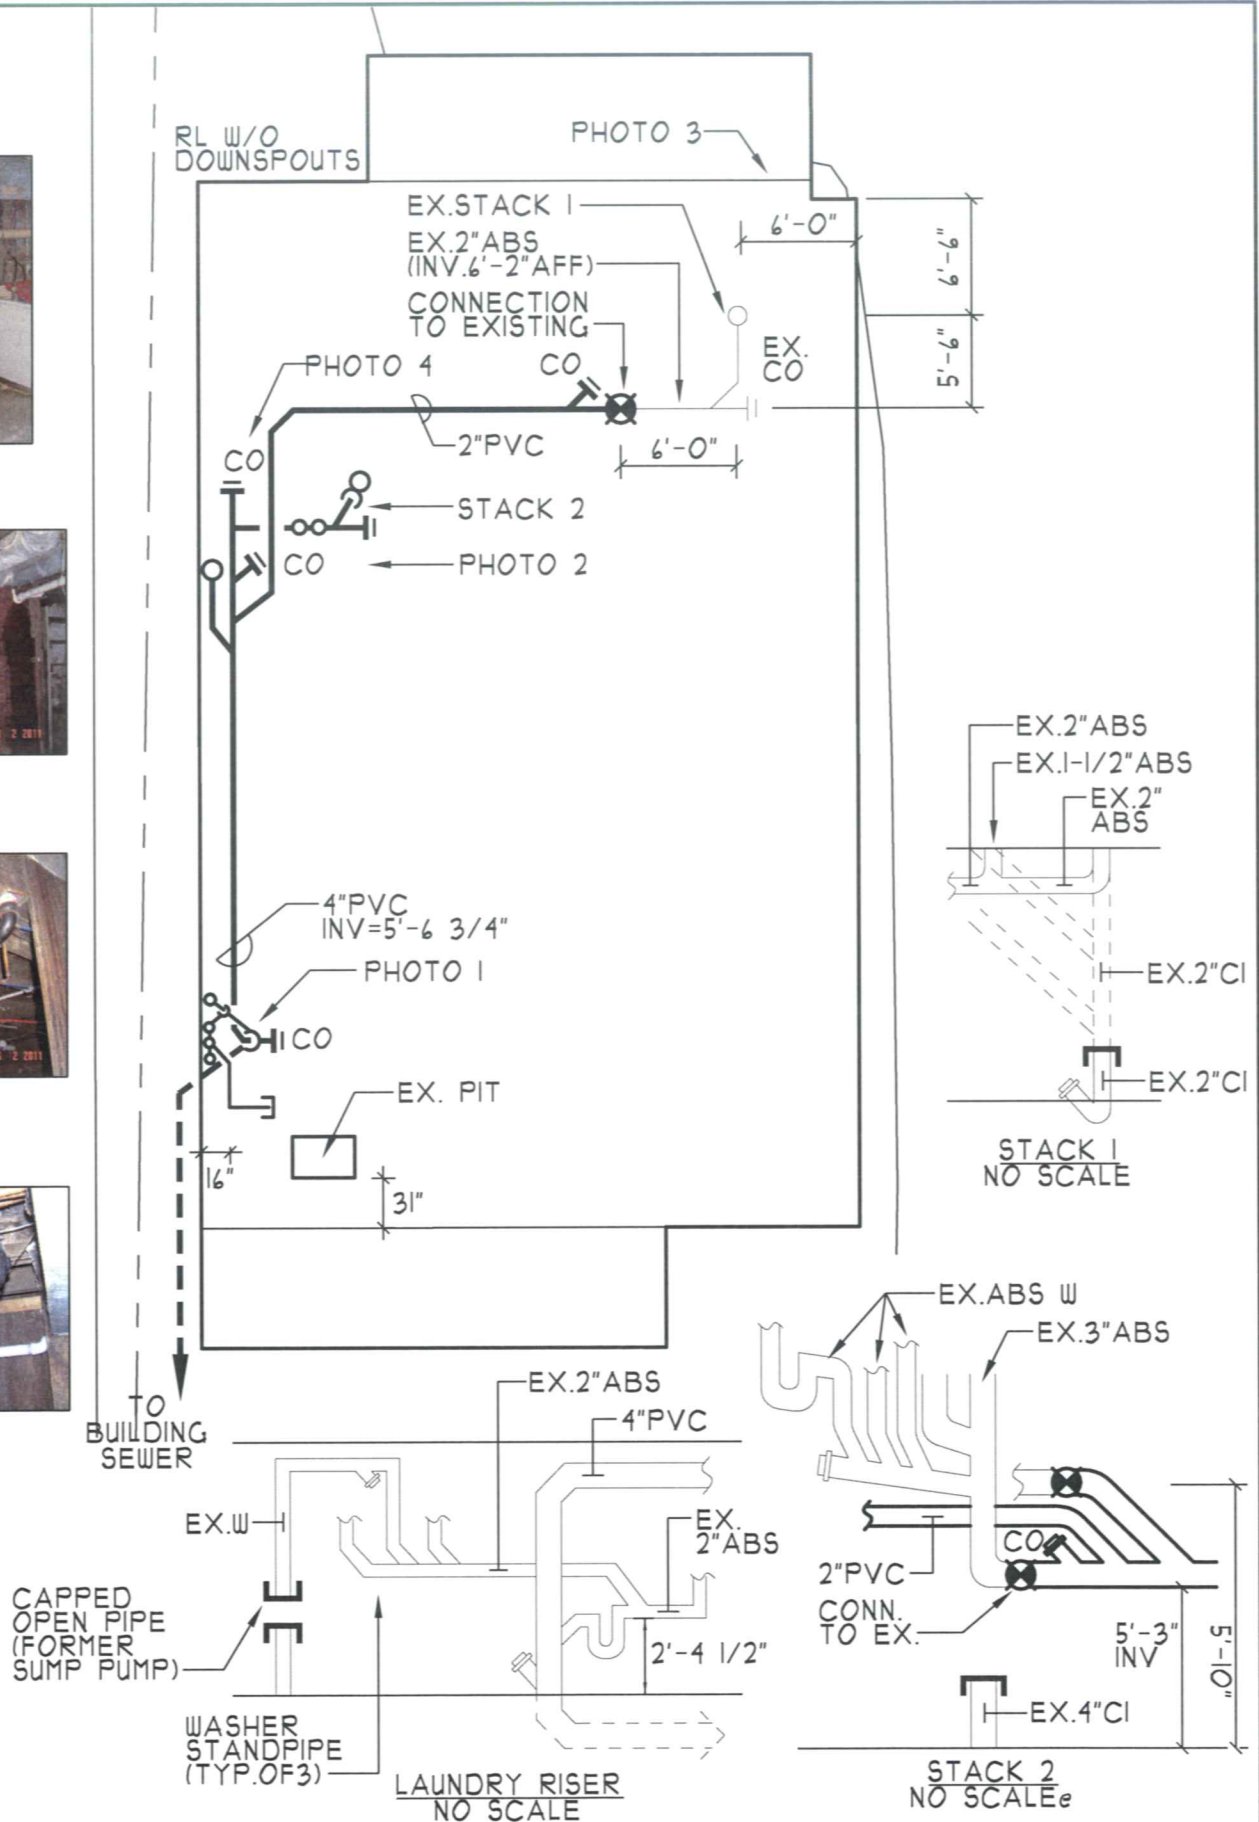

SCALE 1' = 10'

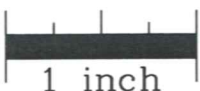

**108-110
EDGEWOOD STREET**
RAIN LEADER AND PLUMBING
REPORT INFORMATION

SOIL STACK No.1

- * MATERIAL PVC CI GALV. OTHER
- * HEIGHT TO BRANCH 6'-3"
- * PHOTO 3
- * SIZE 2

SOIL STACK No.2

- * MATERIAL PVC CI GALV. OTHER
- * HEIGHT TO BRANCH 5'-3"
- * PHOTO 214
- * SIZE 3

DATE: 8-2-11

JOIST SIZE 4-1/2"

FL. TO CLG 7'-1"