



PHOTO 1



PHOTO 2




PHOTO 3



PHOTO 4



PHOTO 5

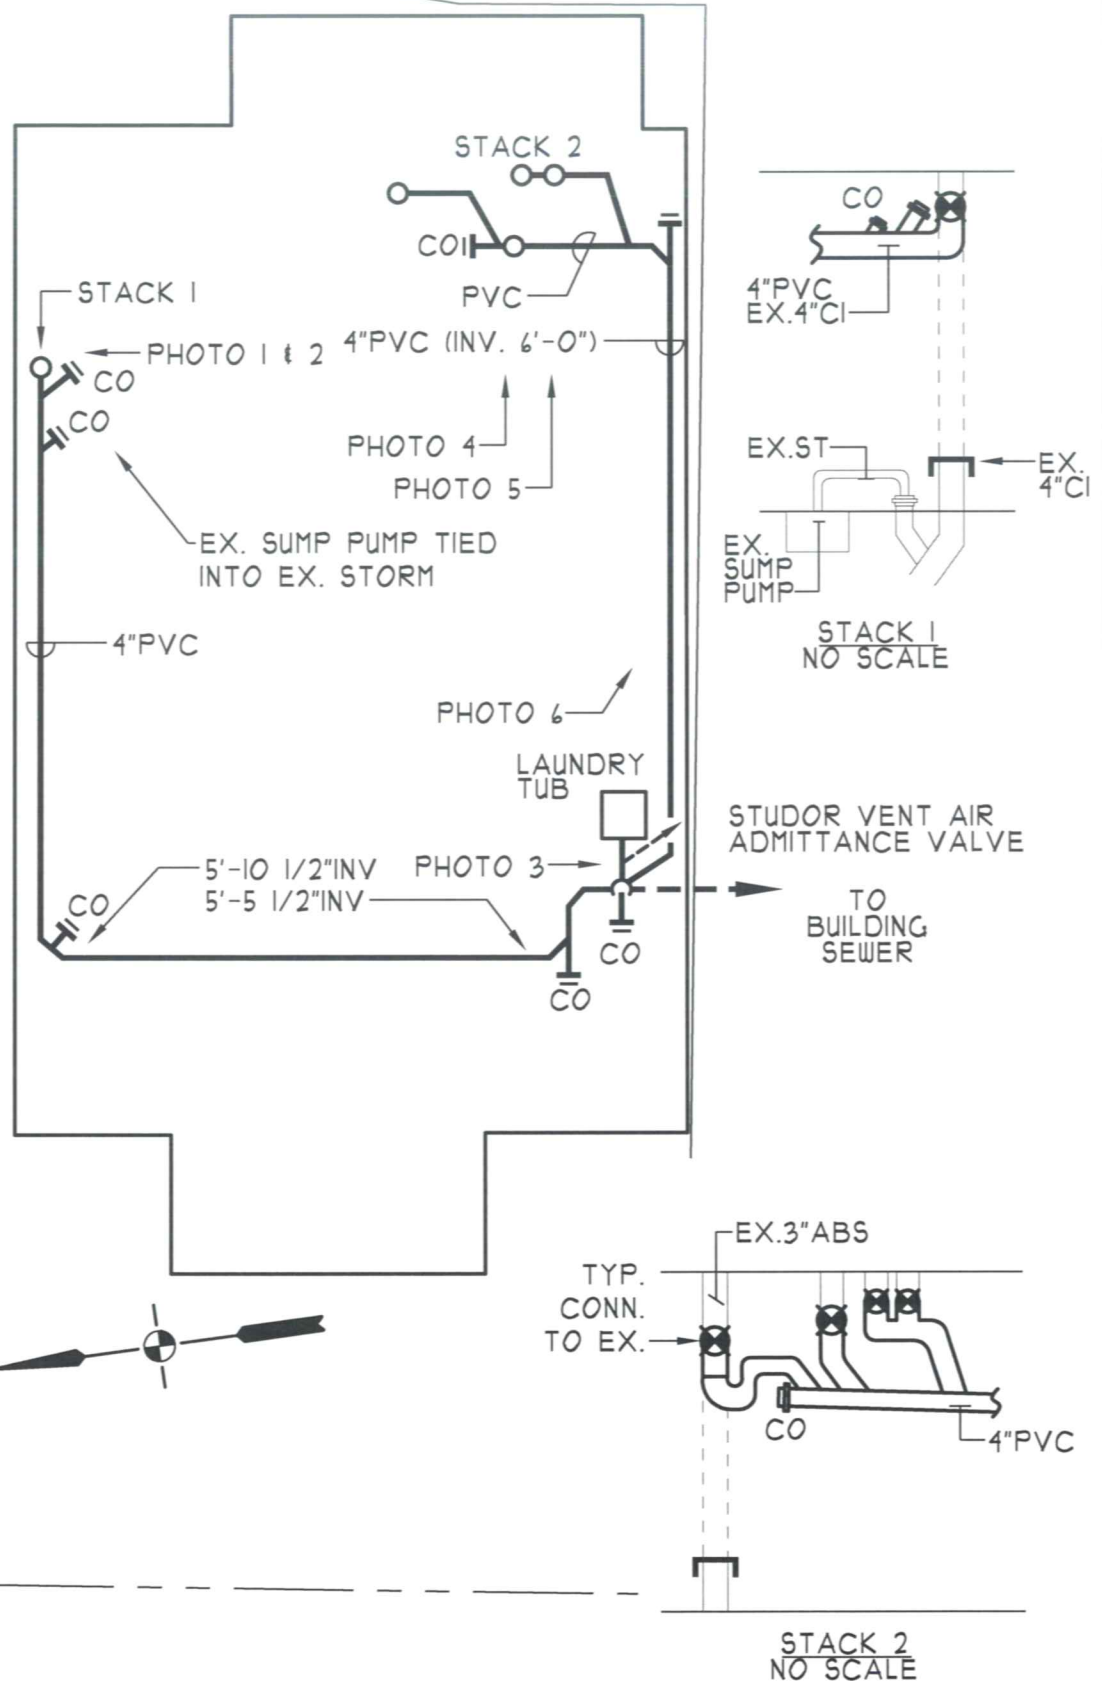

SCALE 1' = 10'



112-114
EDGEWOOD STREET
RAIN LEADER AND PLUMBING
REPORT INFORMATION

SOIL STACK No.1

- MATERIAL PVC CI GALV. OTHER
- HEIGHT TO BRANCH 6'-1"
- PHOTO 1
- SIZE 4"

SOIL STACK No.2

- MATERIAL PVC CI GALV. OTHER
- HEIGHT TO BRANCH 6'-1"
- PHOTO 4
- SIZE 4"

DATE: 8-2-11

JOIST SIZE 8"

FL. TO CLG 7'-1"