



PHOTO 1

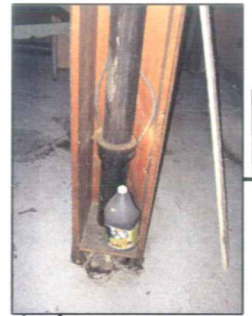


PHOTO 2



PHOTO 3



PHOTO 4





PHOTO 5




PHOTO 6




PHOTO 1

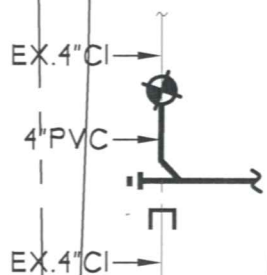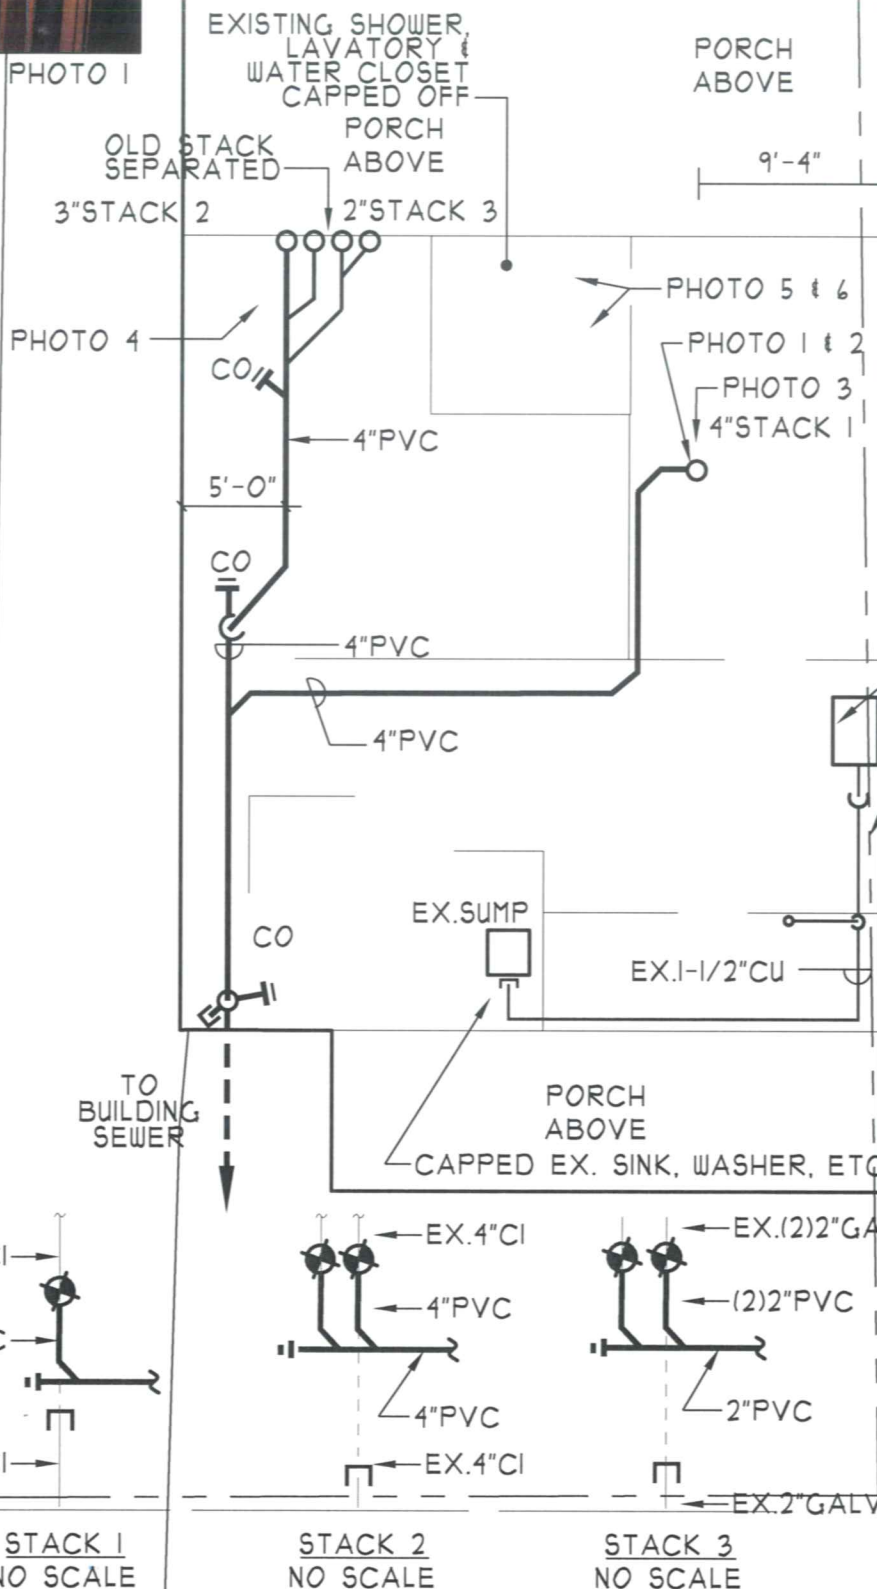

STACK 1
NO SCALE

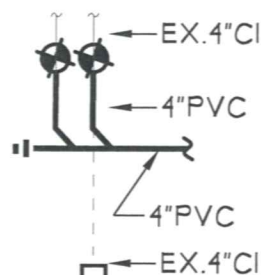

STACK 2
NO SCALE

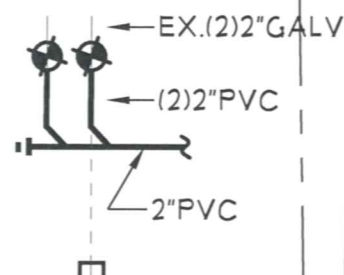

STACK 3
NO SCALE

SCALE 1' = 10'

1 inch

123-125
EDGEWOOD STREET
RAIN LEADER AND PLUMBING
REPORT INFORMATION

SOIL STACK No.1

- MATERIAL PVC CI GALV. OTHER
- HEIGHT TO BRANCH 1'-2"
- PHOTO
- SIZE 3"

SOIL STACK No.2

- MATERIAL PVC CI GALV. OTHER
- HEIGHT TO BRANCH 5'-3"
- PHOTO
- SIZE 2"

DATE: 8-18-11

JOIST SIZE 7'-4"

FL. TO CLG 9"