



PHOTO 1



PHOTO 2

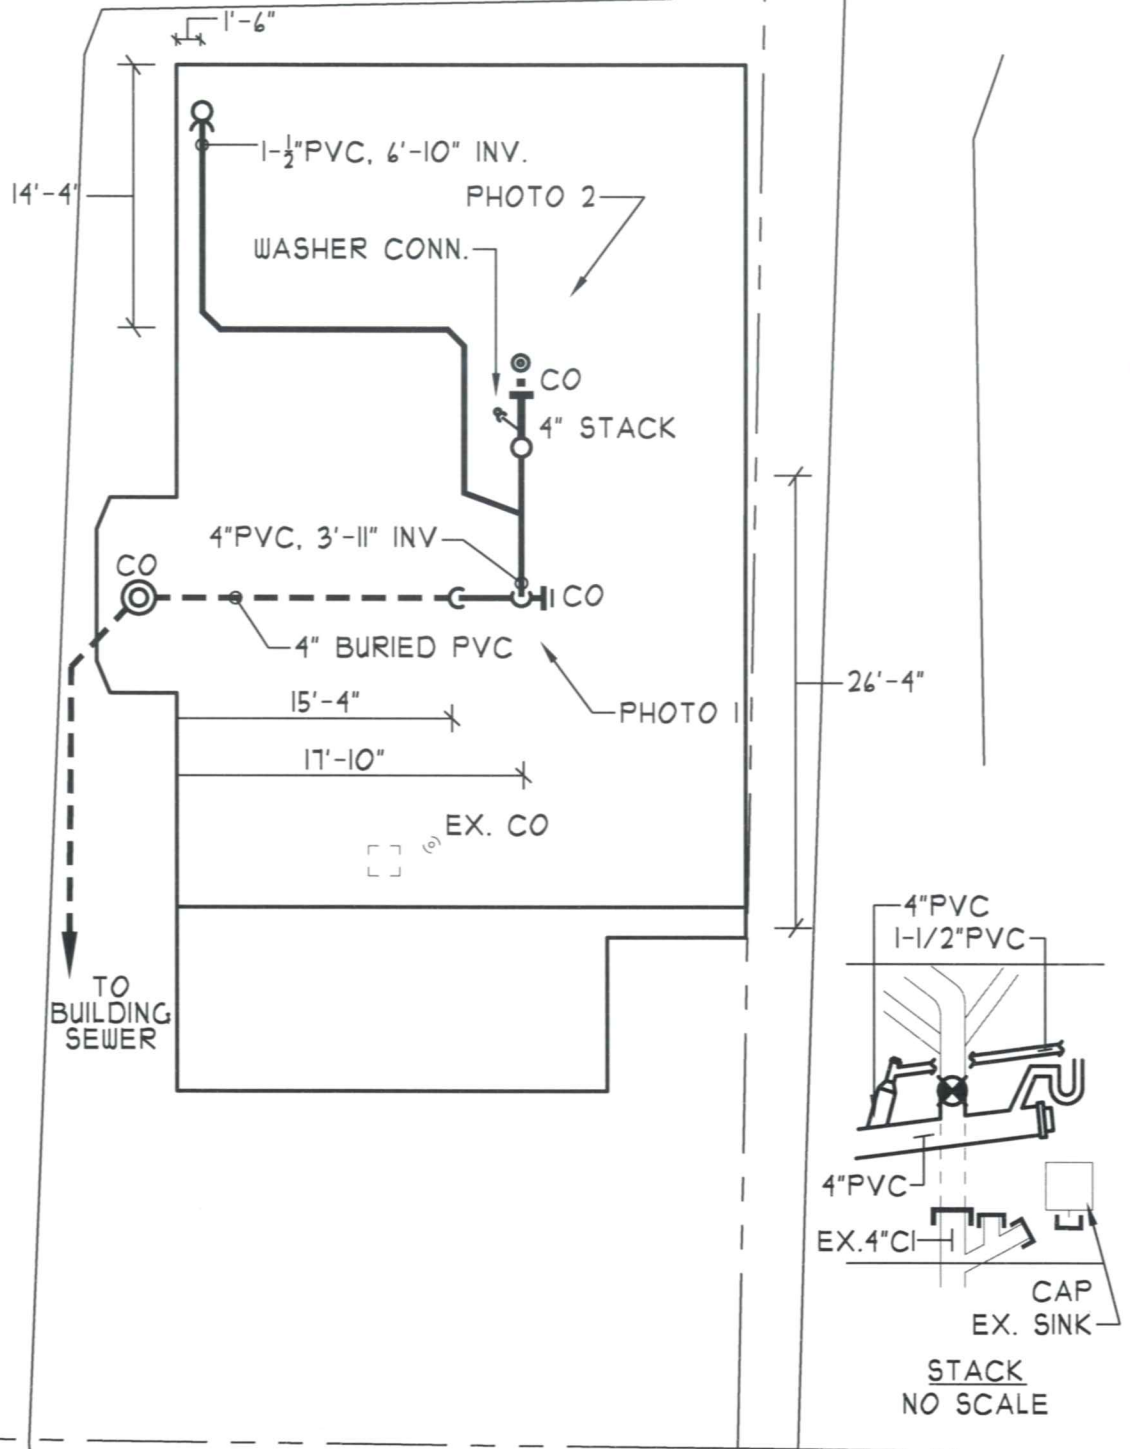

SCALE 1' = 10'

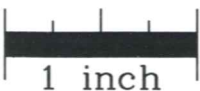

139-141
EDGEWOOD STREET
RAIN LEADER AND PLUMBING
REPORT INFORMATION

SOIL STACK No.1

• MATERIAL PVC CI GALV. OTHER
• HEIGHT TO BRANCH 4'-0"
• PHOTO 2
• SIZE 4"

SOIL STACK No.2

• MATERIAL PVC CI GALV. OTHER
• HEIGHT TO BRANCH _____
• PHOTO _____
• SIZE _____

DATE: 8-3-11

JOIST SIZE 9"

FL. TO CLG 7'-1"