



PHOTO 1

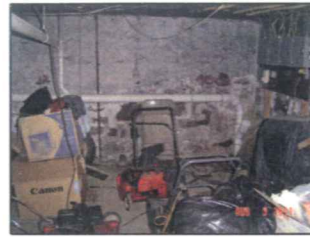


PHOTO 2


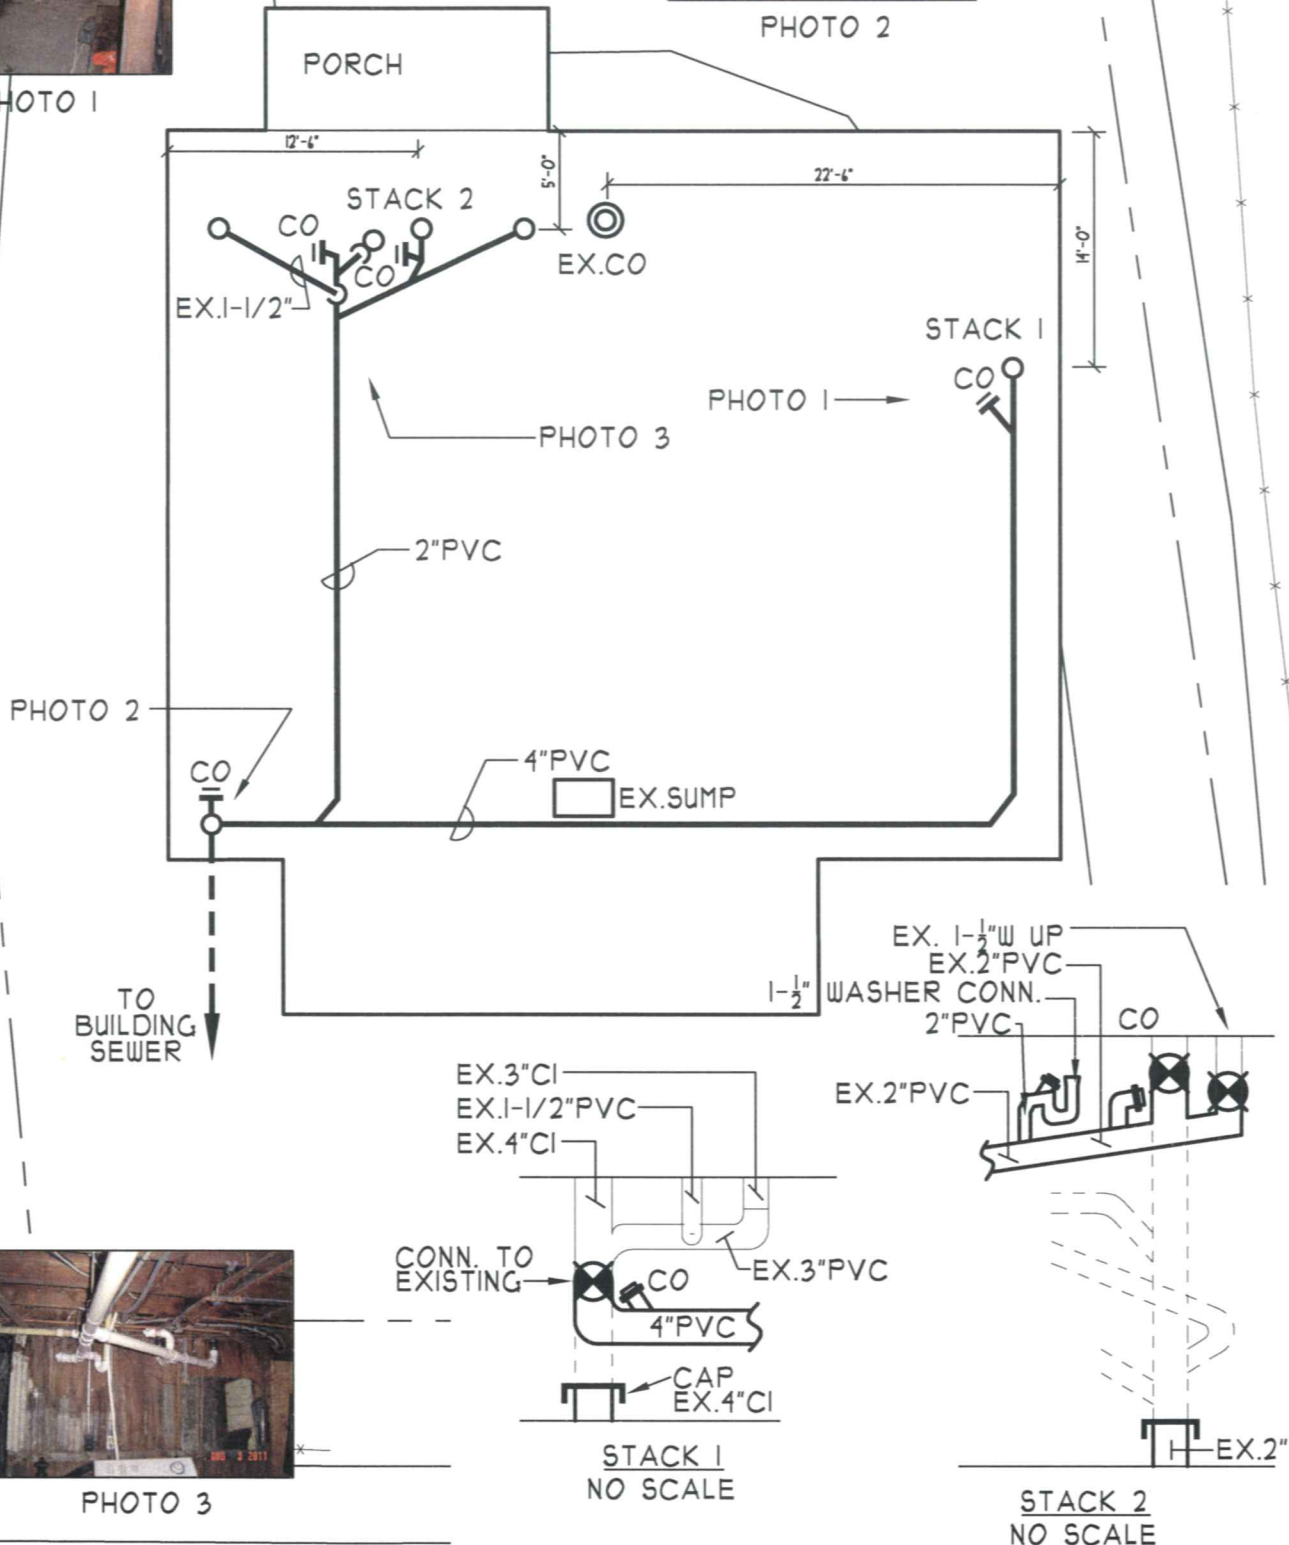


PHOTO 3

SCALE 1" = 10'

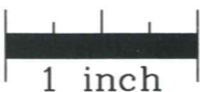

**148-150
EDGEWOOD STREET**
RAIN LEADER AND PLUMBING
REPORT INFORMATION

SOIL STACK No.1

- MATERIAL PVC CI GALV. OTHER
- HEIGHT TO BRANCH
- PHOTO 1
- SIZE 3

SOIL STACK No.2

- MATERIAL PVC CI GALV. OTHER
- HEIGHT TO BRANCH 5'-9"
- PHOTO 3
- SIZE 2

DATE: 8-3-11

JOIST SIZE 7'-6"

FL. TO CLG 9"