



PHOTO 1




PHOTO 2




PHOTO 3



PHOTO 4

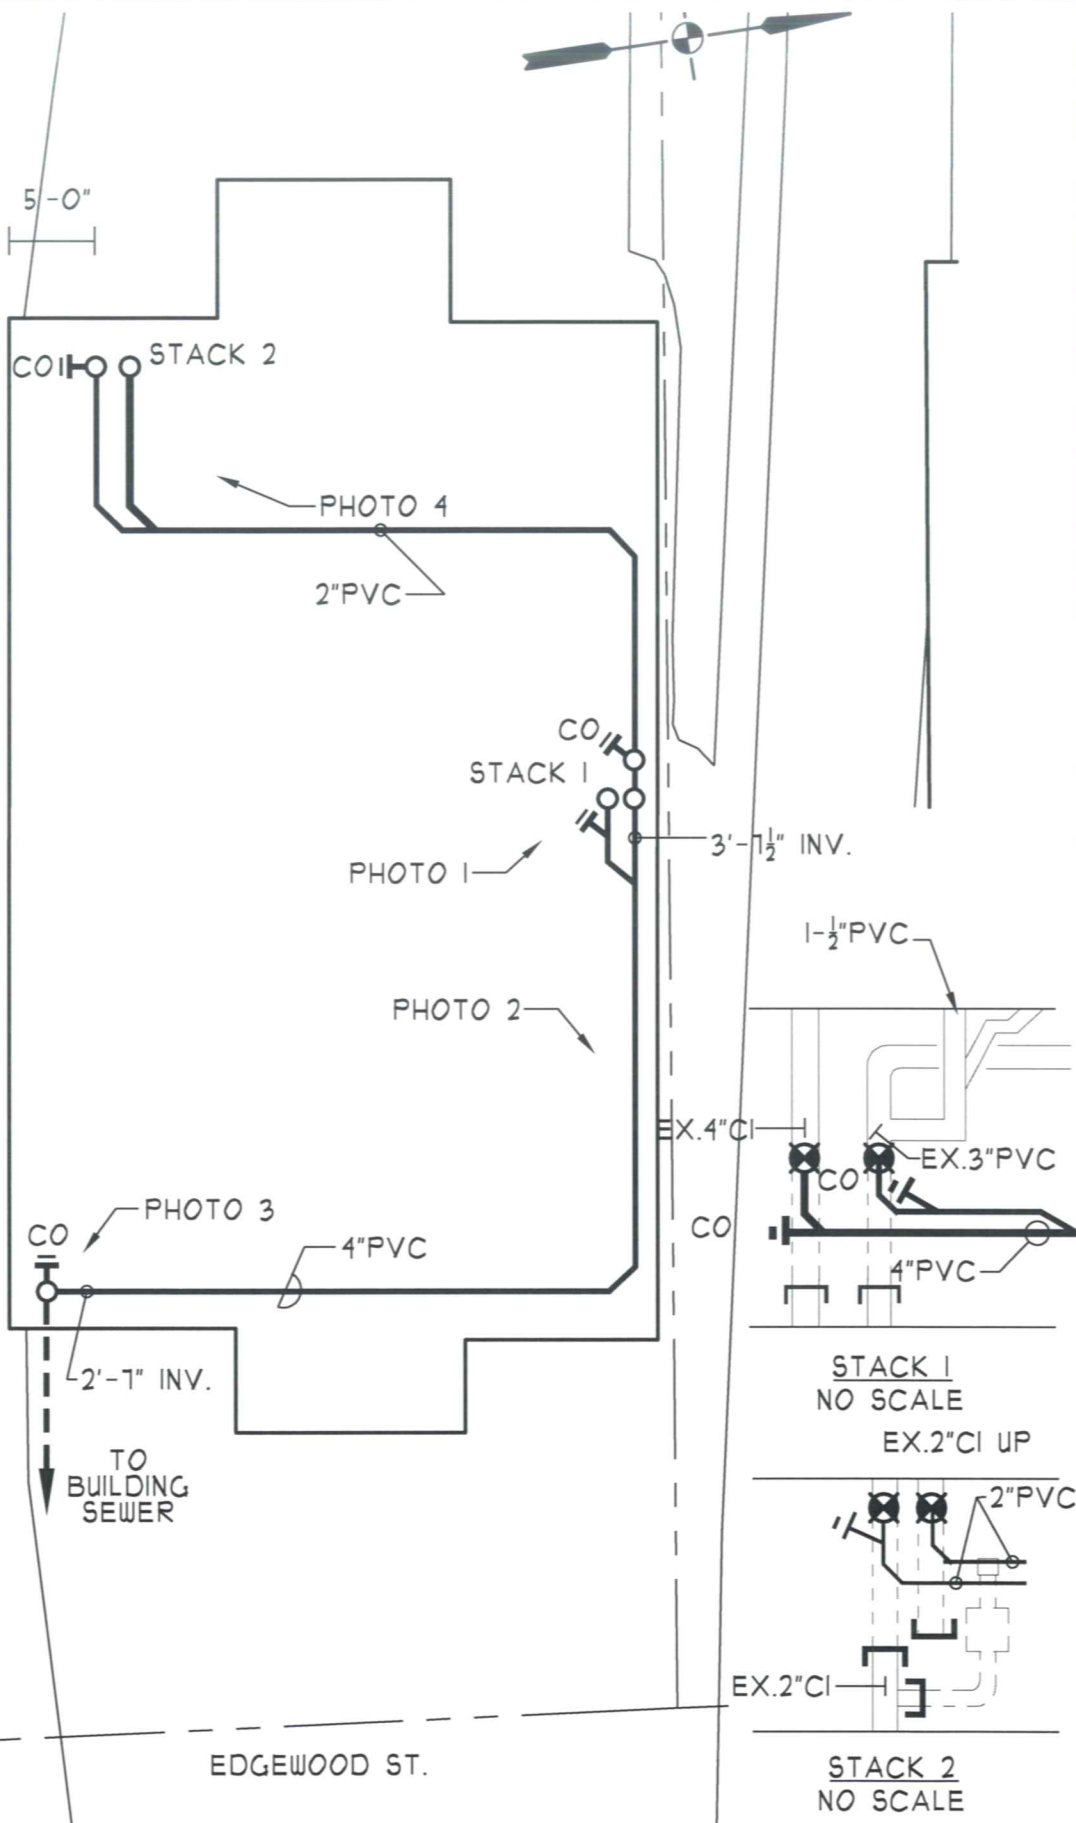

SCALE 1' = 10'

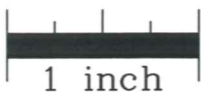

**155-157
EDGEWOOD STREET**
RAIN LEADER AND PLUMBING
REPORT INFORMATION

SOIL STACK No.1

- MATERIAL PVC CI GALV. OTHER
- HEIGHT TO BRANCH 3'-1 1/2"
- PHOTO 1
- SIZE 4"

SOIL STACK No.2

- MATERIAL PVC CI GALV. OTHER
- HEIGHT TO BRANCH 1'-0"
- PHOTO 2
- SIZE 2"

DATE: 8-3-11

JOIST SIZE 9"

FL. TO CLG 1'-2"