



PHOTO 1




PHOTO 2




PHOTO 3



PHOTO 4

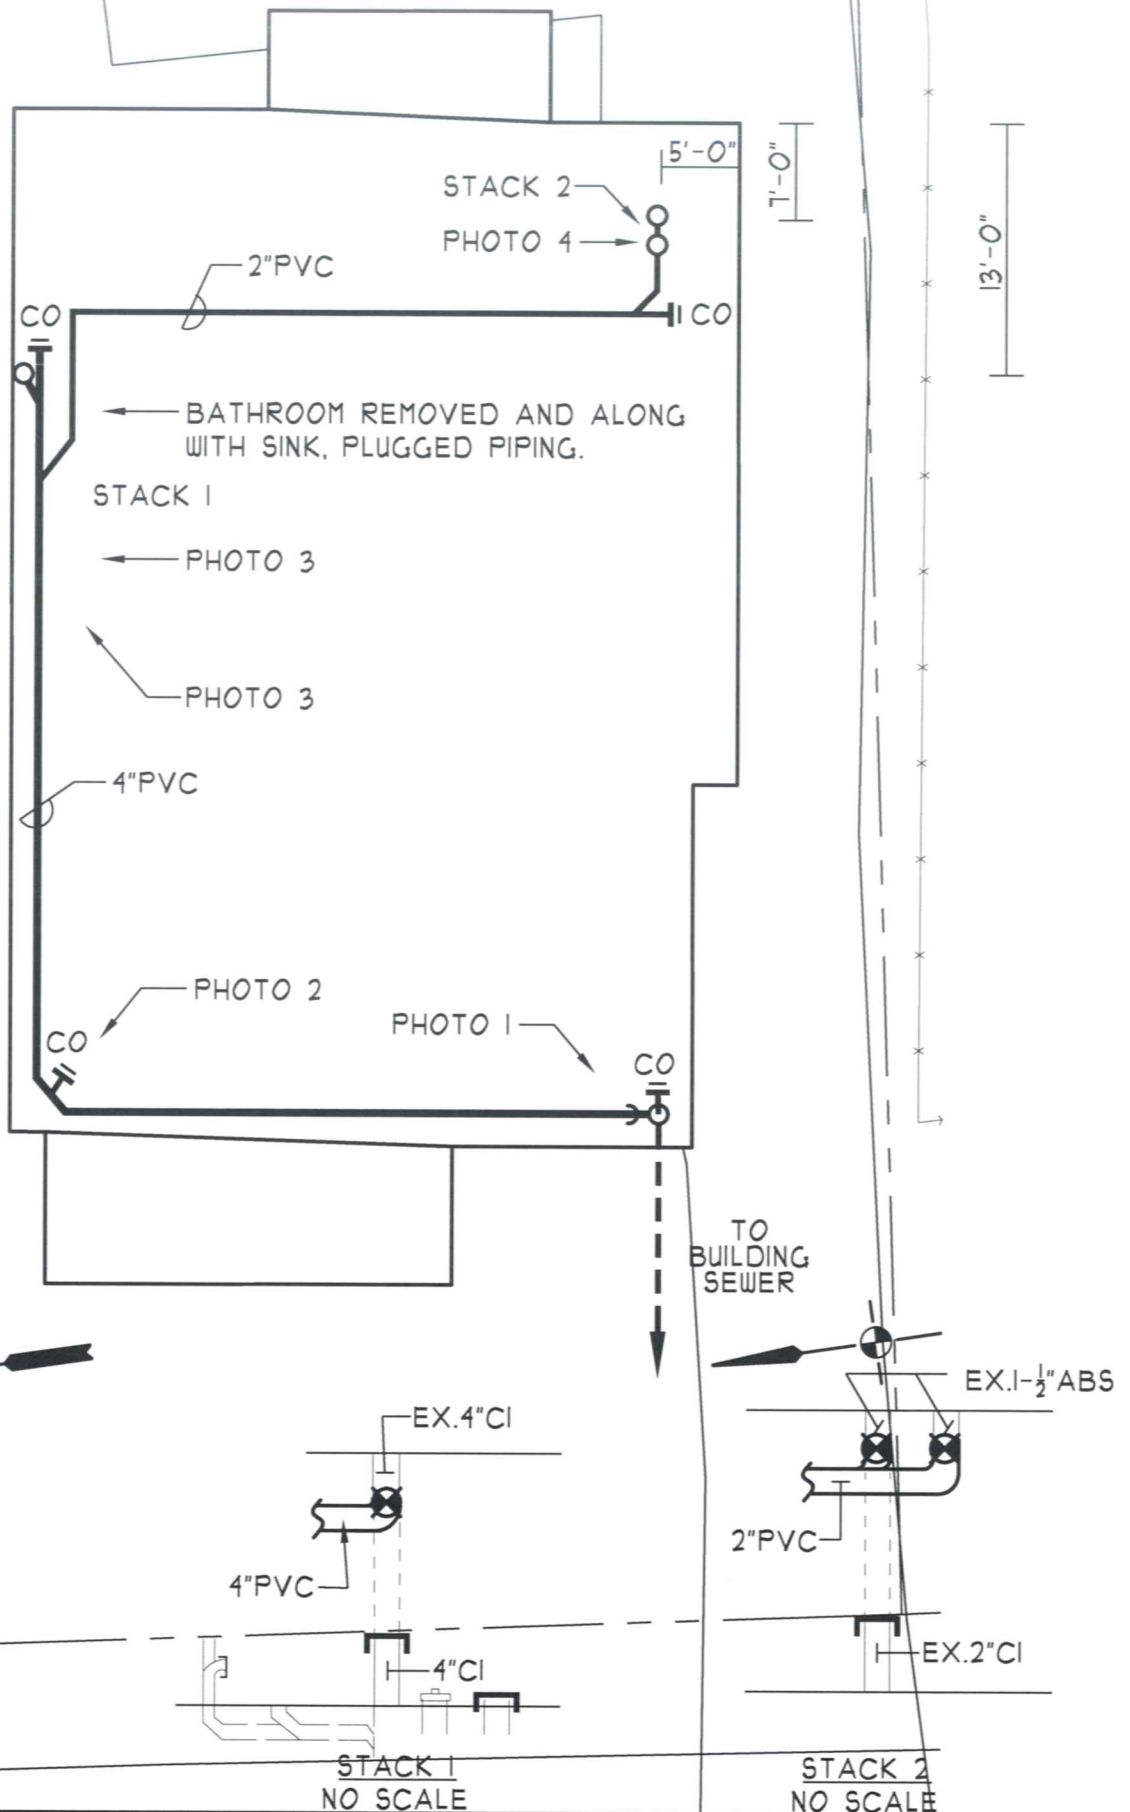

SCALE 1" = 10'

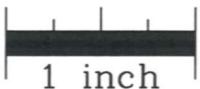

156-158
EDGEWOOD STREET
RAIN LEADER AND PLUMBING
REPORT INFORMATION

SOIL STACK No.1

- MATERIAL PVC CI GALV. OTHER
- HEIGHT TO BRANCH 6'-2"
- PHOTO 4
- SIZE 2"

SOIL STACK No.2

- MATERIAL PVC CI GALV. OTHER
- HEIGHT TO BRANCH 6'-8"
- PHOTO 4
- SIZE 2"

DATE: 8-3-11

JOIST SIZE 9"

FL. TO CLG 6'-8"