

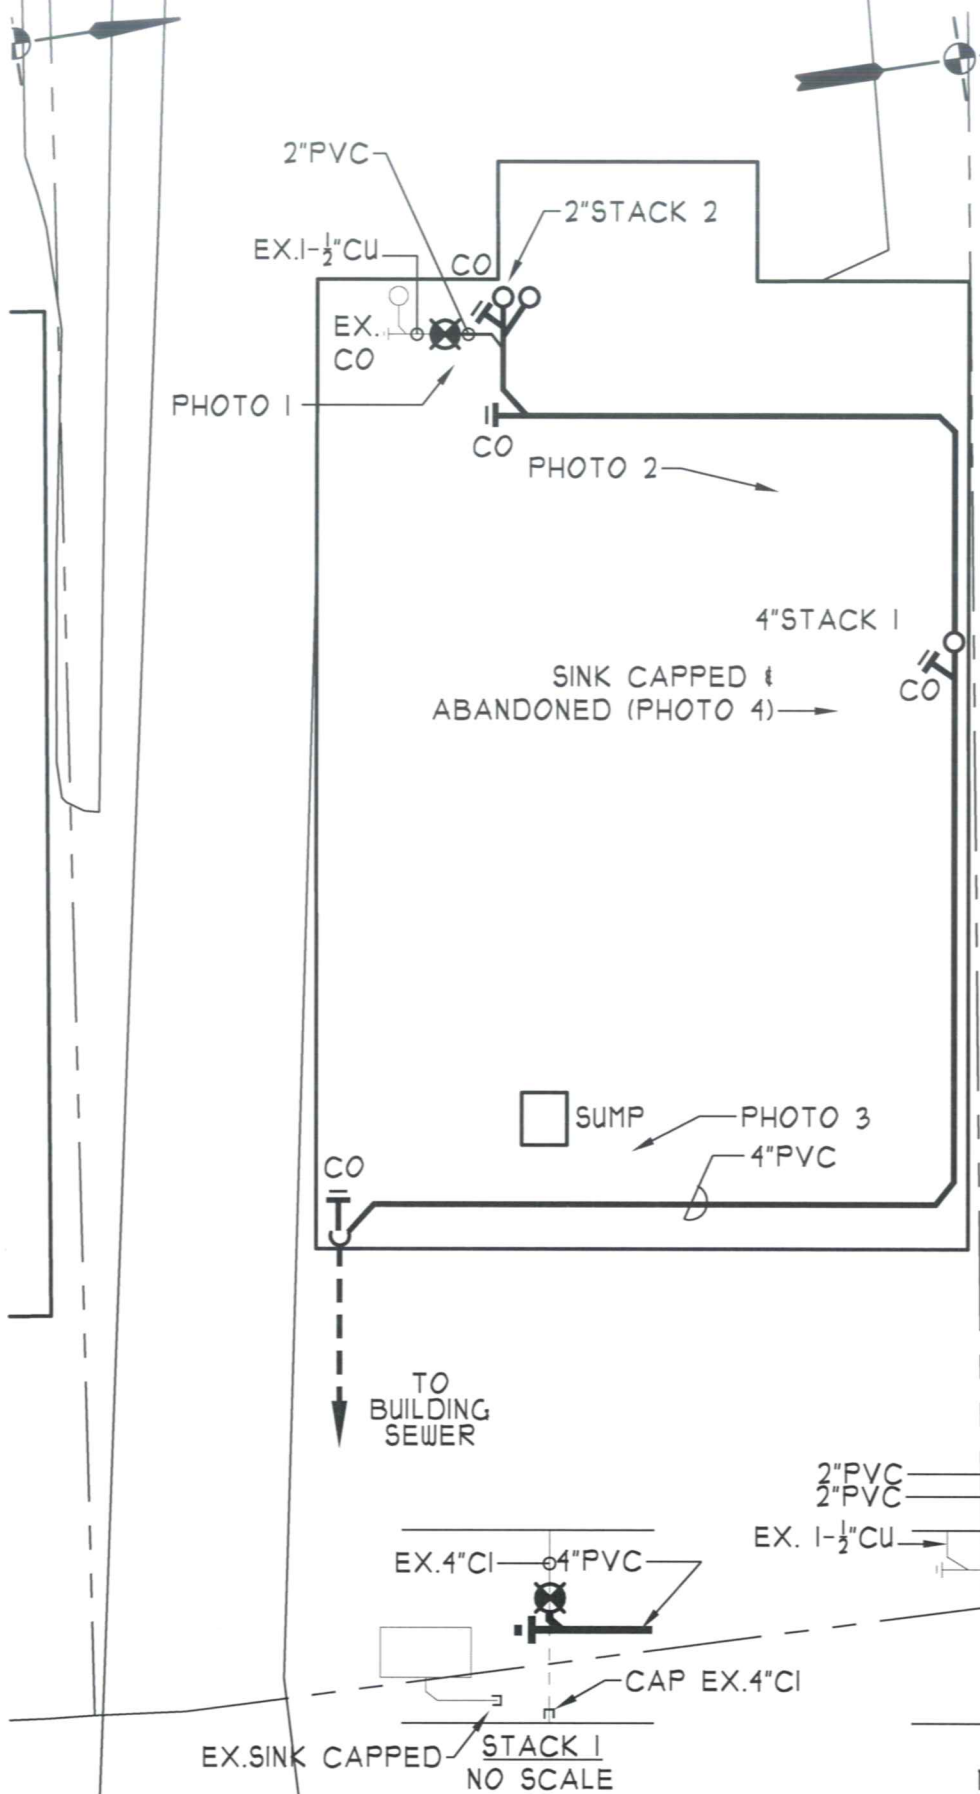


PHOTO 1



PHOTO 2



PHOTO 3

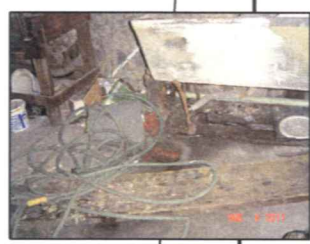


PHOTO 4

SCALE 1' = 10'

1 inch

163-165
EDGEWOOD STREET
 RAIN LEADER AND PLUMBING
 REPORT INFORMATION

SOIL STACK No.1

- MATERIAL PVC © GALV. OTHER
- HEIGHT TO BRANCH 3'-9 1/2"
- PHOTO 2
- SIZE 4"

SOIL STACK No.2

- MATERIAL PVC © GALV. OTHER
- HEIGHT TO BRANCH
- PHOTO
- SIZE 2"

DATE: 8-4-11

JOIST SIZE

FL. TO CLG