



PHOTO 1



PHOTO 2



PHOTO 3



PHOTO 4





PHOTO 5



PHOTO 6




PHOTO 7

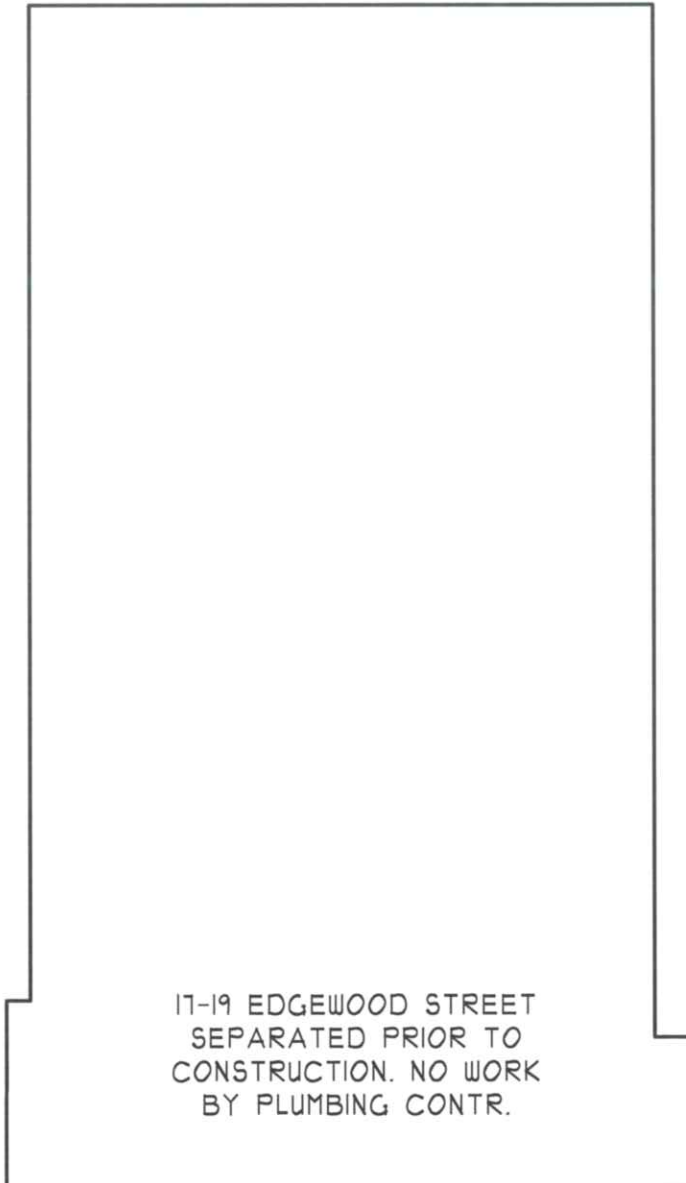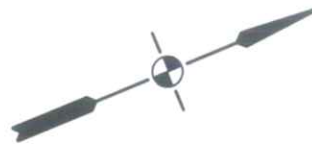

17-19 EDGEWOOD STREET
SEPARATED PRIOR TO
CONSTRUCTION. NO WORK
BY PLUMBING CONTR.

EDGEWOOD STREET

SCALE 1' = 10'

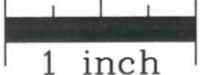

**17-19
EDGEWOOD STREET**
RAIN LEADER AND PLUMBING
REPORT INFORMATION

SOIL STACK No.1

- MATERIAL PVC CI GALV. OTHER _____
- HEIGHT TO BRANCH _____
- PHOTO _____
- SIZE _____

SOIL STACK No.2

- MATERIAL PVC CI GALV. OTHER _____
- HEIGHT TO BRANCH _____
- PHOTO _____
- SIZE _____

INTERIOR
SEPARATION
PREDATES
MDC
PROJECT