



PHOTO 1



PHOTO 2



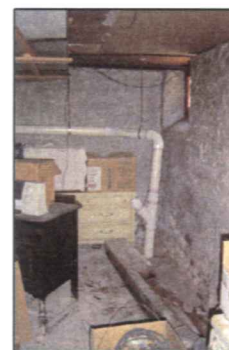



PHOTO 3



PHOTO 4

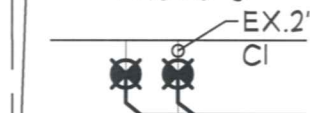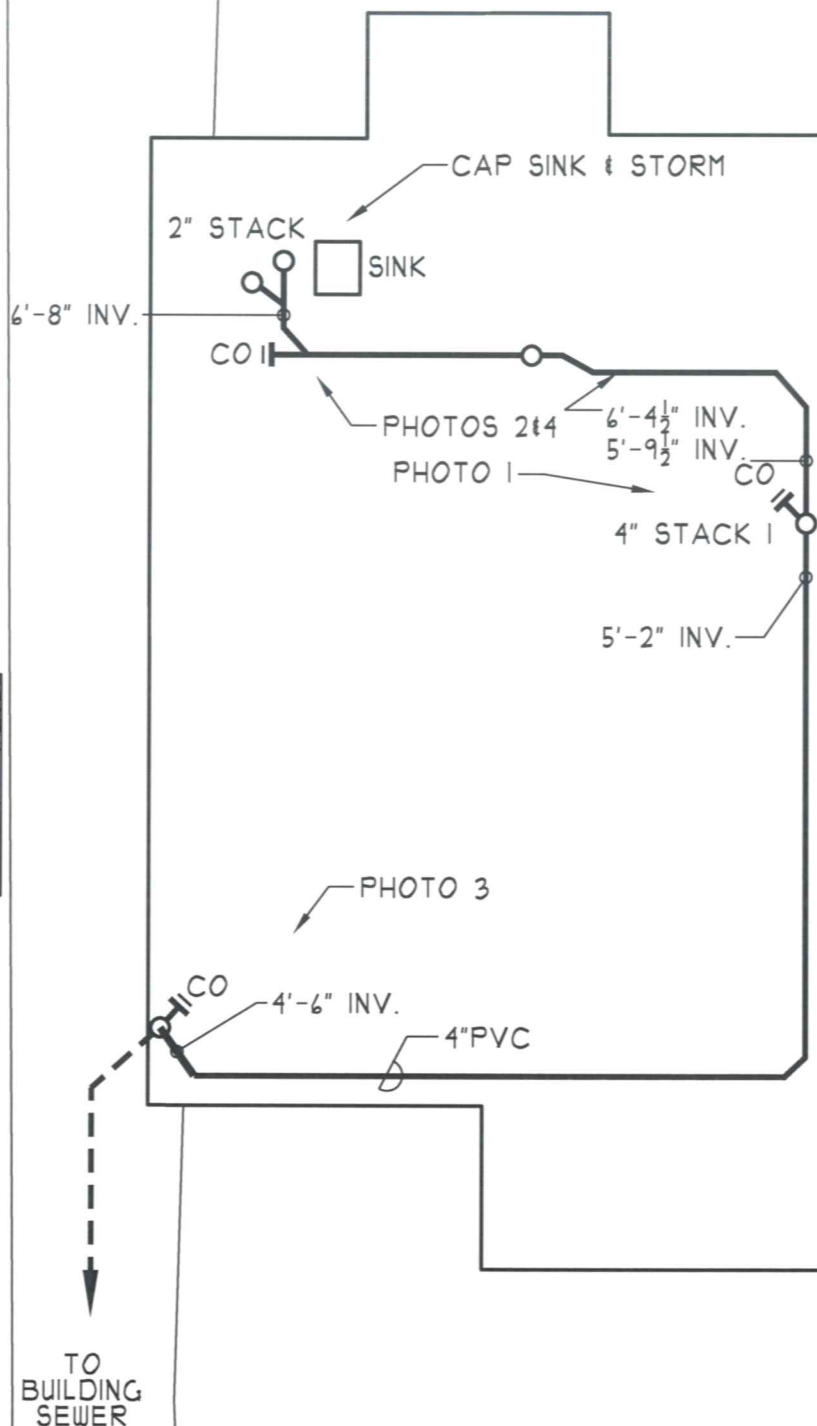


STACK 2

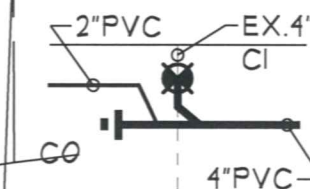

STACK 1

SCALE 1' = 10'

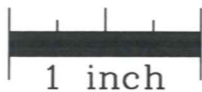

171-173
EDGEWOOD STREET
RAIN LEADER AND PLUMBING
REPORT INFORMATION

SOIL STACK No.1

- MATERIAL PVC CI GALV. OTHER
- HEIGHT TO BRANCH 5'-2"
- PHOTO 1
- SIZE 4"

SOIL STACK No.2

- MATERIAL PVC CI GALV. OTHER
- HEIGHT TO BRANCH 6'-8"
- PHOTO 2
- SIZE 2"

DATE: 8-4-11

JOIST SIZE 9"

FL. TO CLG. 7'-3"