

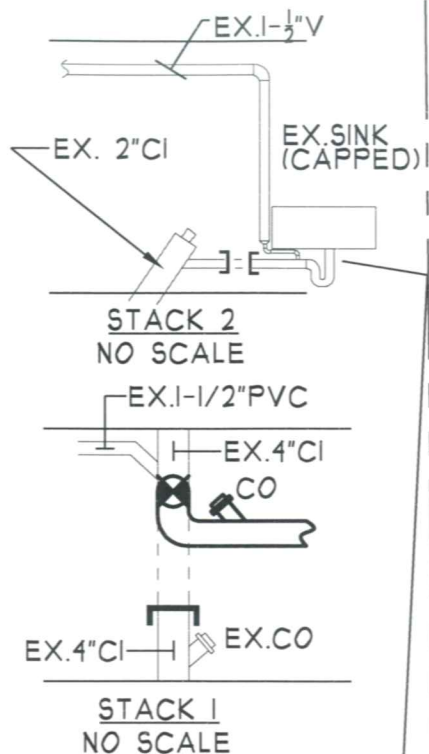



PHOTO 1




PHOTO 2



PHOTO 3

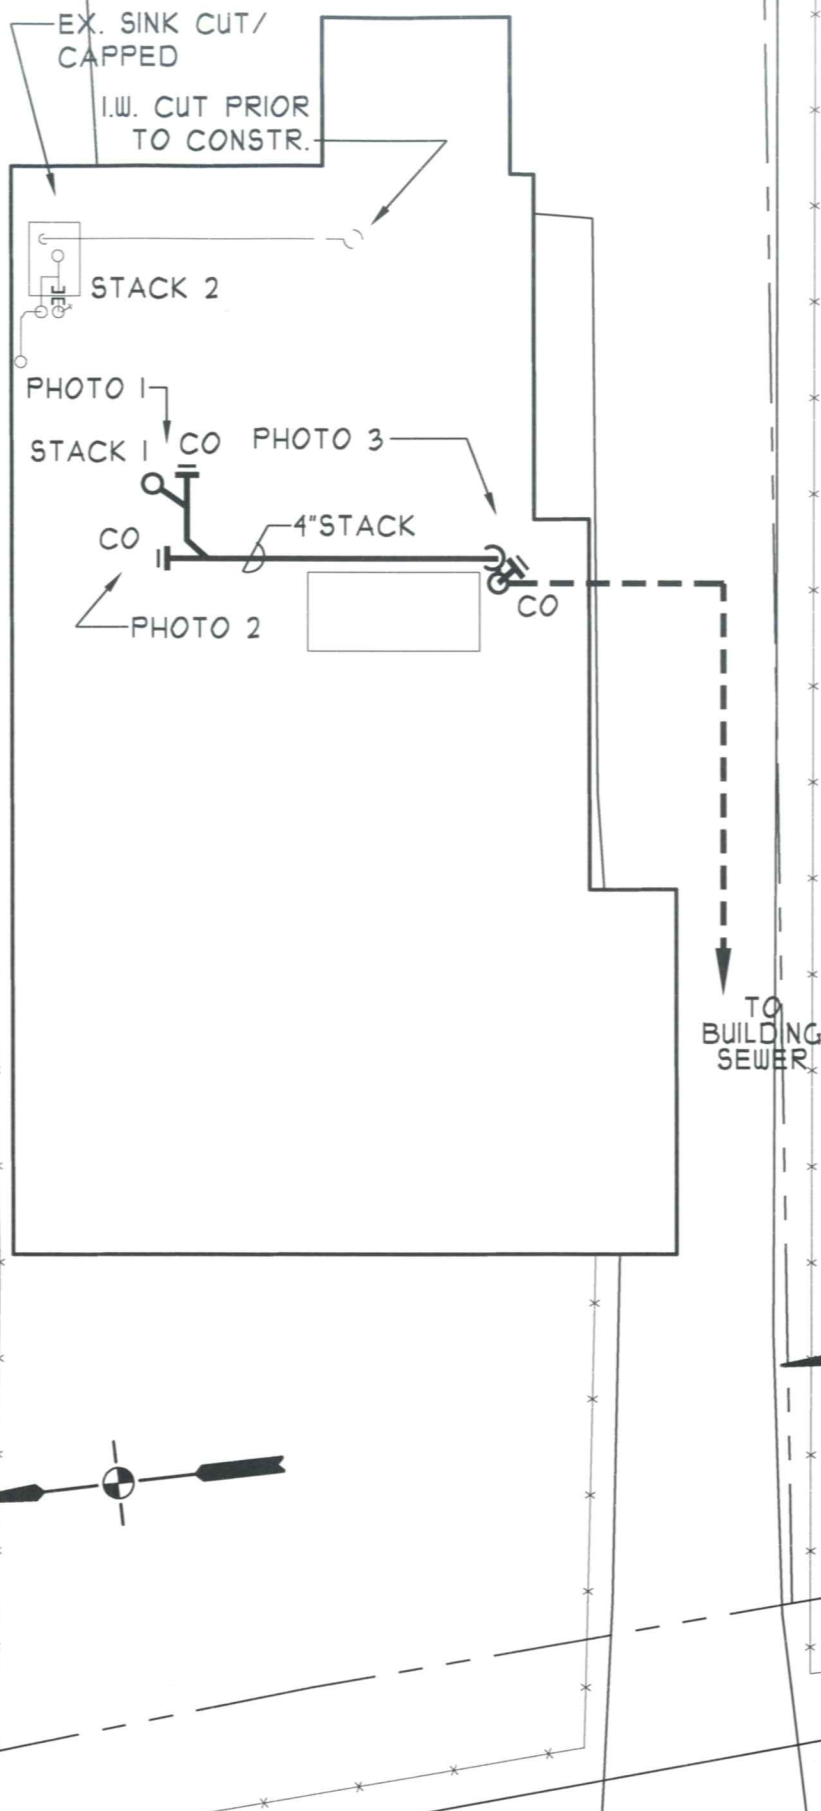

SCALE 1' = 10'

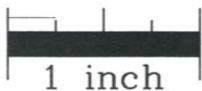

186-188
EDGEWOOD STREET
RAIN LEADER AND PLUMBING
REPORT INFORMATION

SOIL STACK No.1

- MATERIAL PVC CI GALV. OTHER
- HEIGHT TO BRANCH 6'-5"
- PHOTO 1
- SIZE 4"

SOIL STACK No.2

- MATERIAL PVC CI GALV. OTHER
- HEIGHT TO BRANCH 6'-5"
- PHOTO 1
- SIZE 4"

DATE: 8-3-11

JOIST SIZE 7'-1"

FL. TO CLG 8"