

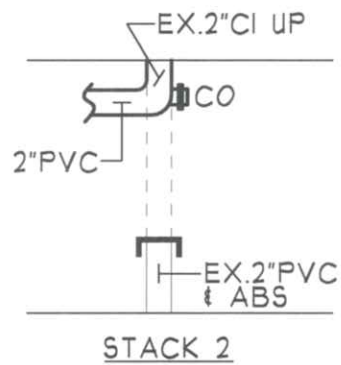
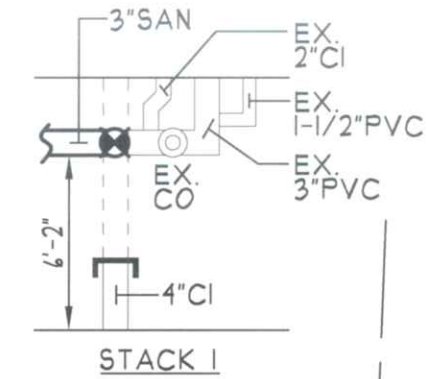



PHOTO 1




PHOTO 2



PHOTO 3

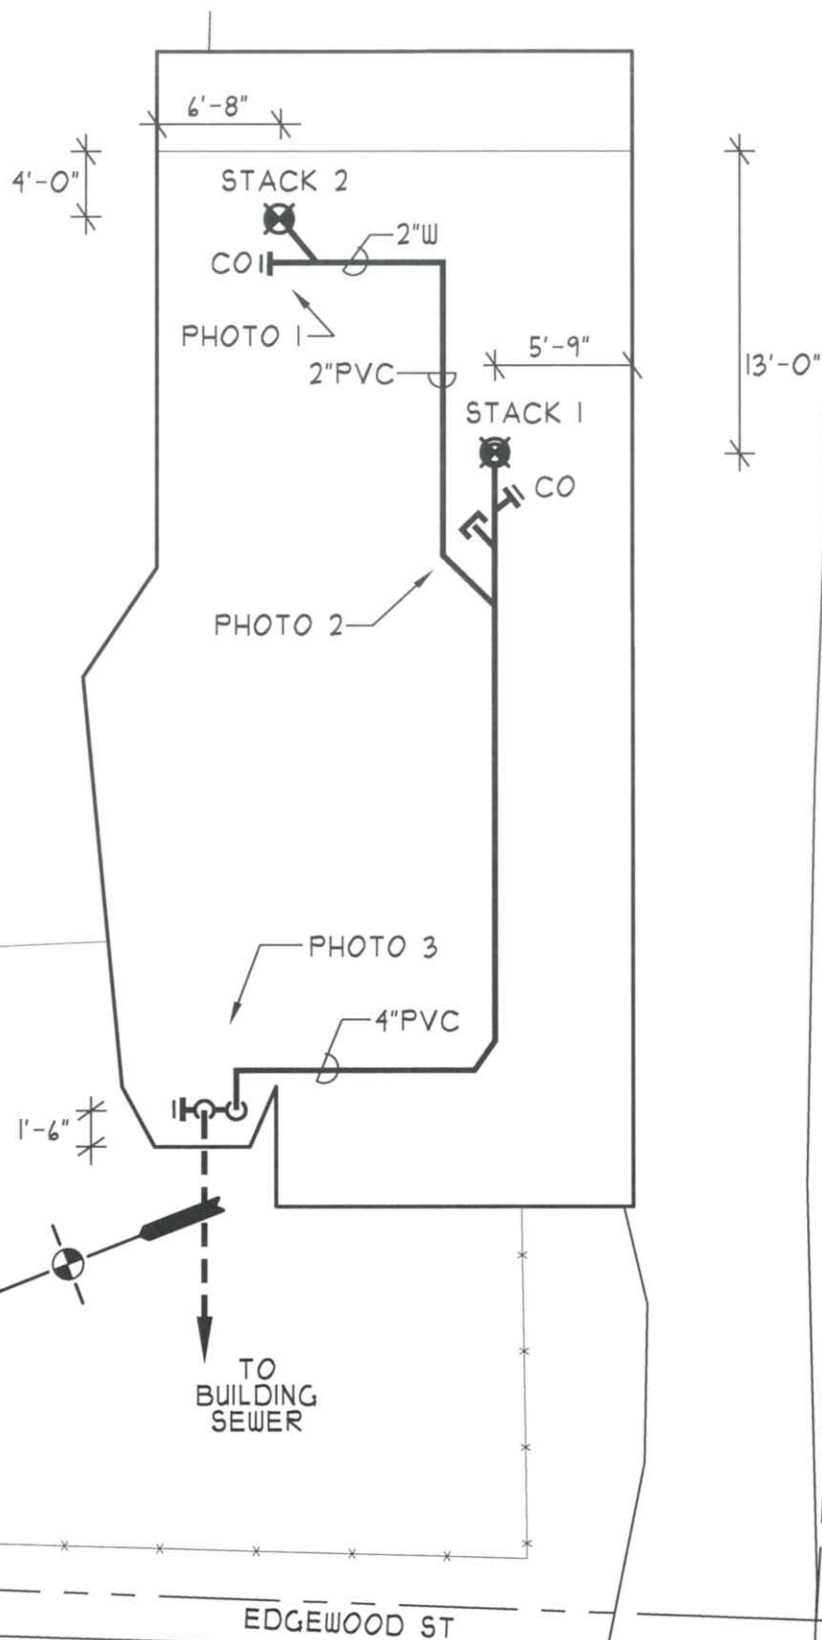

SCALE 1' = 10'

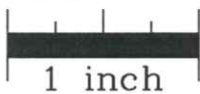

26-28 EDGEWOOD STREET

RAIN LEADER AND PLUMBING
REPORT INFORMATION

SOIL STACK No.1

- MATERIAL PVC CI GALV. OTHER
- HEIGHT TO BRANCH 6'-2"
- PHOTO 2
- SIZE 3"

SOIL STACK No.2

- MATERIAL PVC CI GALV. OTHER
- HEIGHT TO BRANCH 5'-8"
- PHOTO 1
- SIZE 2"

DATE: 7-29-11

JOIST SIZE 10"

FL. TO CLG. 7'-2"