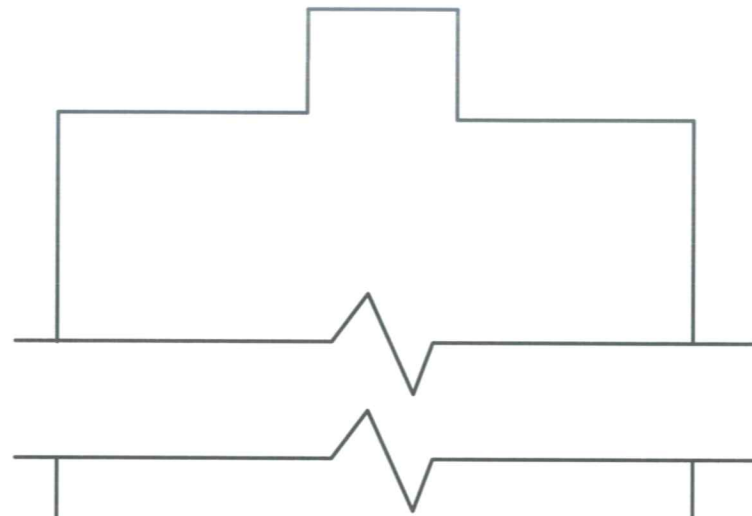




PHOTO 1

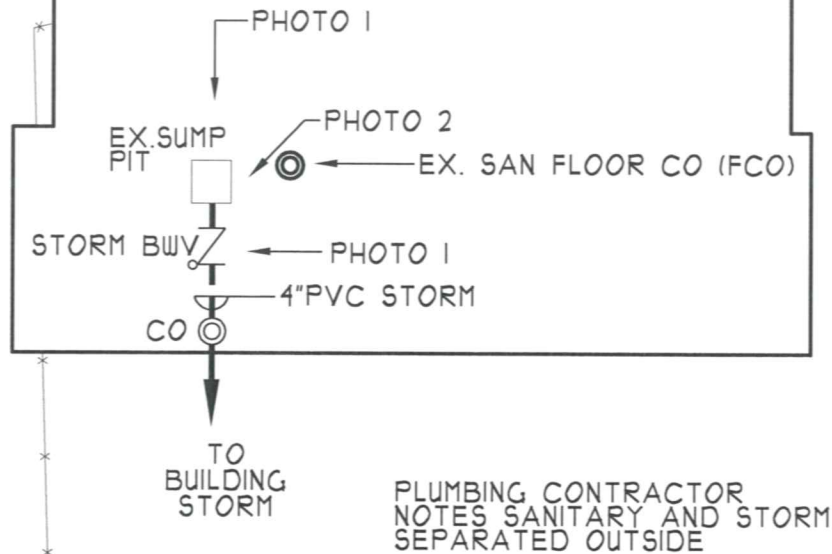


PHOTO 2




PLUMBING CONTRACTOR
NOTES NO WORK DONE TO
EX. SANITARY IN BUILDING AS
SEPARATED OUTSIDE

EX. STACK 1 EX. STACK 2



SCALE 1' = 10'

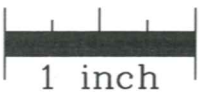

27
EDGEWOOD STREET
RAIN LEADER AND PLUMBING
REPORT INFORMATION

SOIL STACK No.1

- MATERIAL PVC CI GALV. OTHER _____
- HEIGHT TO BRANCH _____
- PHOTO _____
- SIZE _____ (N/A)

SOIL STACK No.2

- MATERIAL PVC CI GALV. OTHER _____
- HEIGHT TO BRANCH _____
- PHOTO _____
- SIZE _____ (N/A)

DATE: **8-4-11**

JOIST SIZE **9"**

FL. TO CLG **7'-6"**