



PHOTO 5



PHOTO 4



PHOTO 3



PHOTO 2


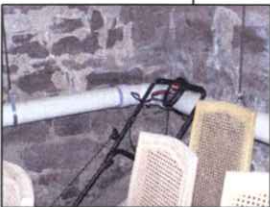



PHOTO 1

STACK (PHOTO 4)

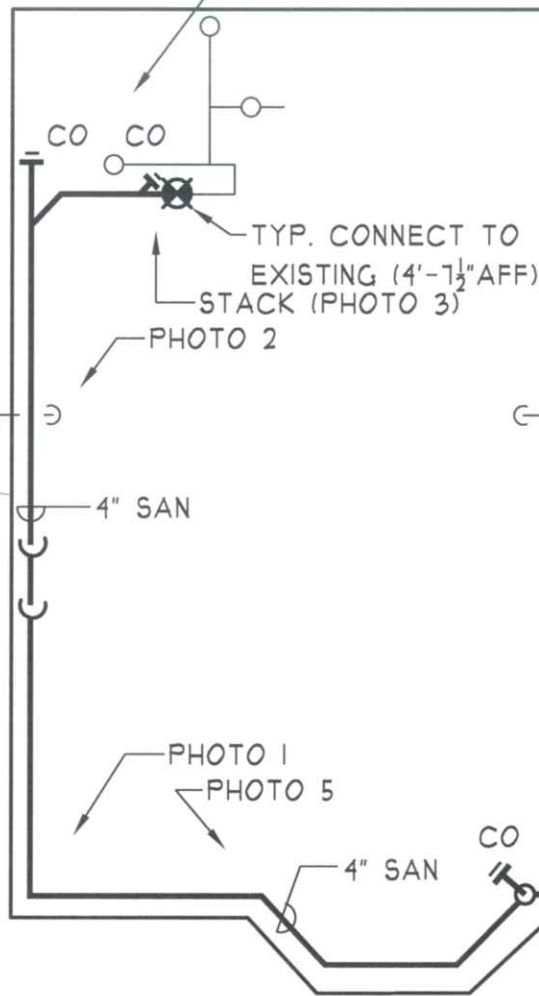

EDGEWOOD ST.

SCALE 1' = 10'

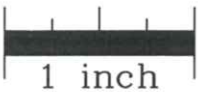

**30-32
EDGEWOOD STREET**
RAIN LEADER AND PLUMBING
REPORT INFORMATION

SOIL STACK No.1

• MATERIAL PVC CI GALV. OTHER _____
• HEIGHT TO BRANCH 5'-3"
• PHOTO 4 6'-8" FL.
• SIZE 3" TO CLG.

SOIL STACK No.2

• MATERIAL PVC CI GALV. OTHER _____
• HEIGHT TO BRANCH _____
• PHOTO _____
• SIZE _____