

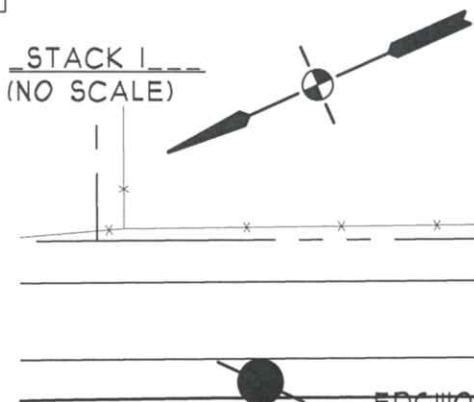




PHOTO 1

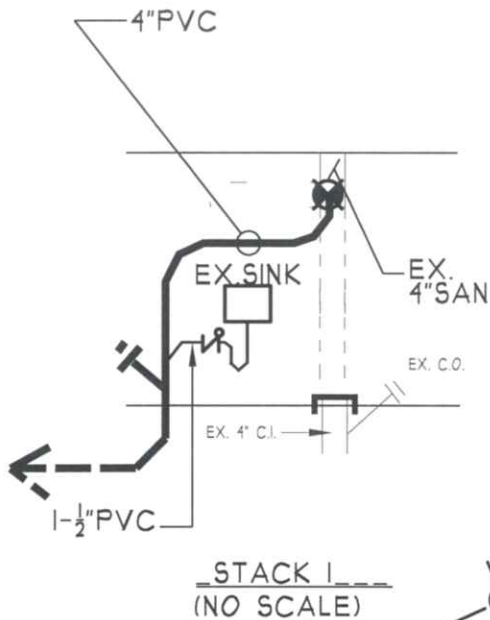

SCALE 1' = 10'

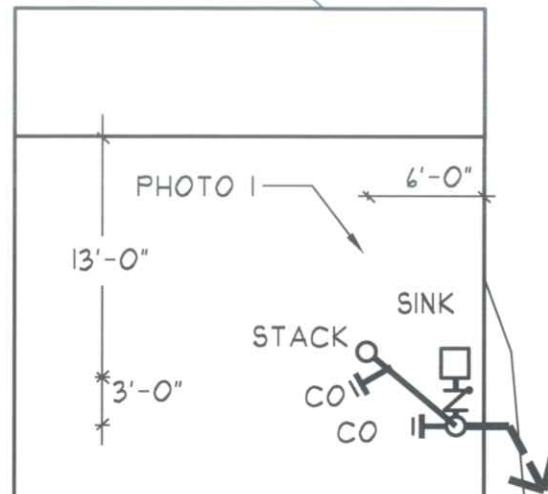

40-42
EDGEWOOD STREET
RAIN LEADER AND PLUMBING
REPORT INFORMATION

SOIL STACK No.1

* MATERIAL PVC CI GALV. OTHER
* HEIGHT TO BRANCH 5'-4"
* PHOTO
* SIZE 4"

SOIL STACK No.2

* MATERIAL PVC CI GALV. OTHER
* HEIGHT TO BRANCH
* PHOTO
* SIZE

DATE: 8-4-11

JOIST SIZE 8"

FL. TO CLG 6'-8 1/2"