

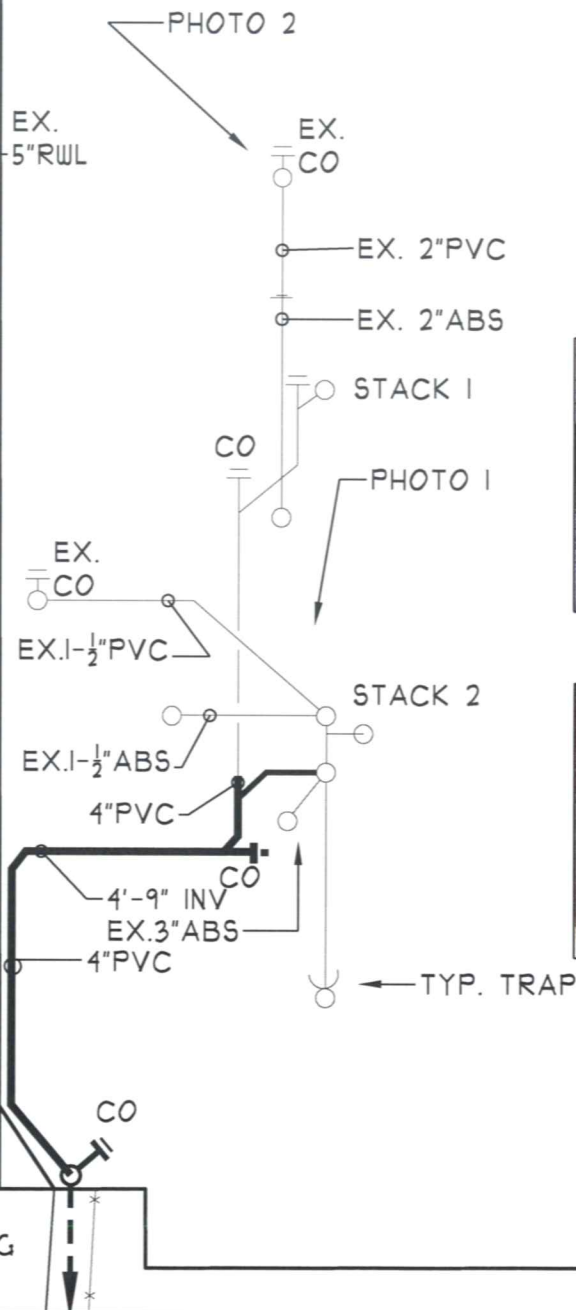
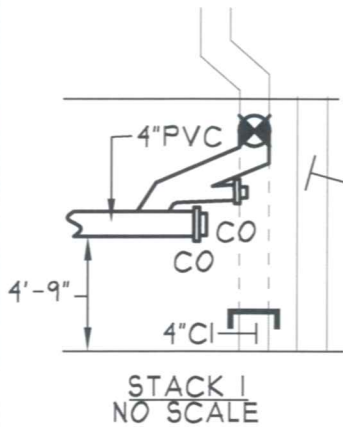
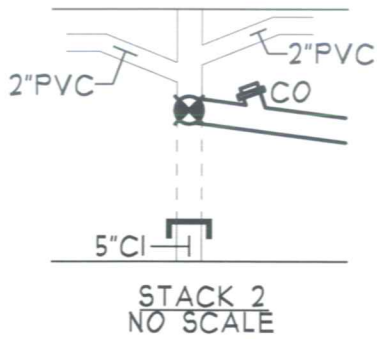


PHOTO 1

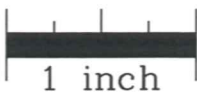


PHOTO 2



PHOTO 3

SCALE 1' = 10'



53-55
EDGEWOOD STREET
RAIN LEADER AND PLUMBING
REPORT INFORMATION

SOIL STACK No.1

- MATERIAL PVC CI GALV. OTHER
- HEIGHT TO BRANCH 5'-9"
- PHOTO 2
- SIZE 4"

SOIL STACK No.2

- MATERIAL PVC CI GALV. OTHER
- HEIGHT TO BRANCH 5'-9"
- PHOTO 1
- SIZE 4"

DATE: 8-9-11

JOIST SIZE 8"

FL. TO CLG 7'-8"