



PHOTO 1



PHOTO 2




PHOTO 3




PHOTO 4



PHOTO 5

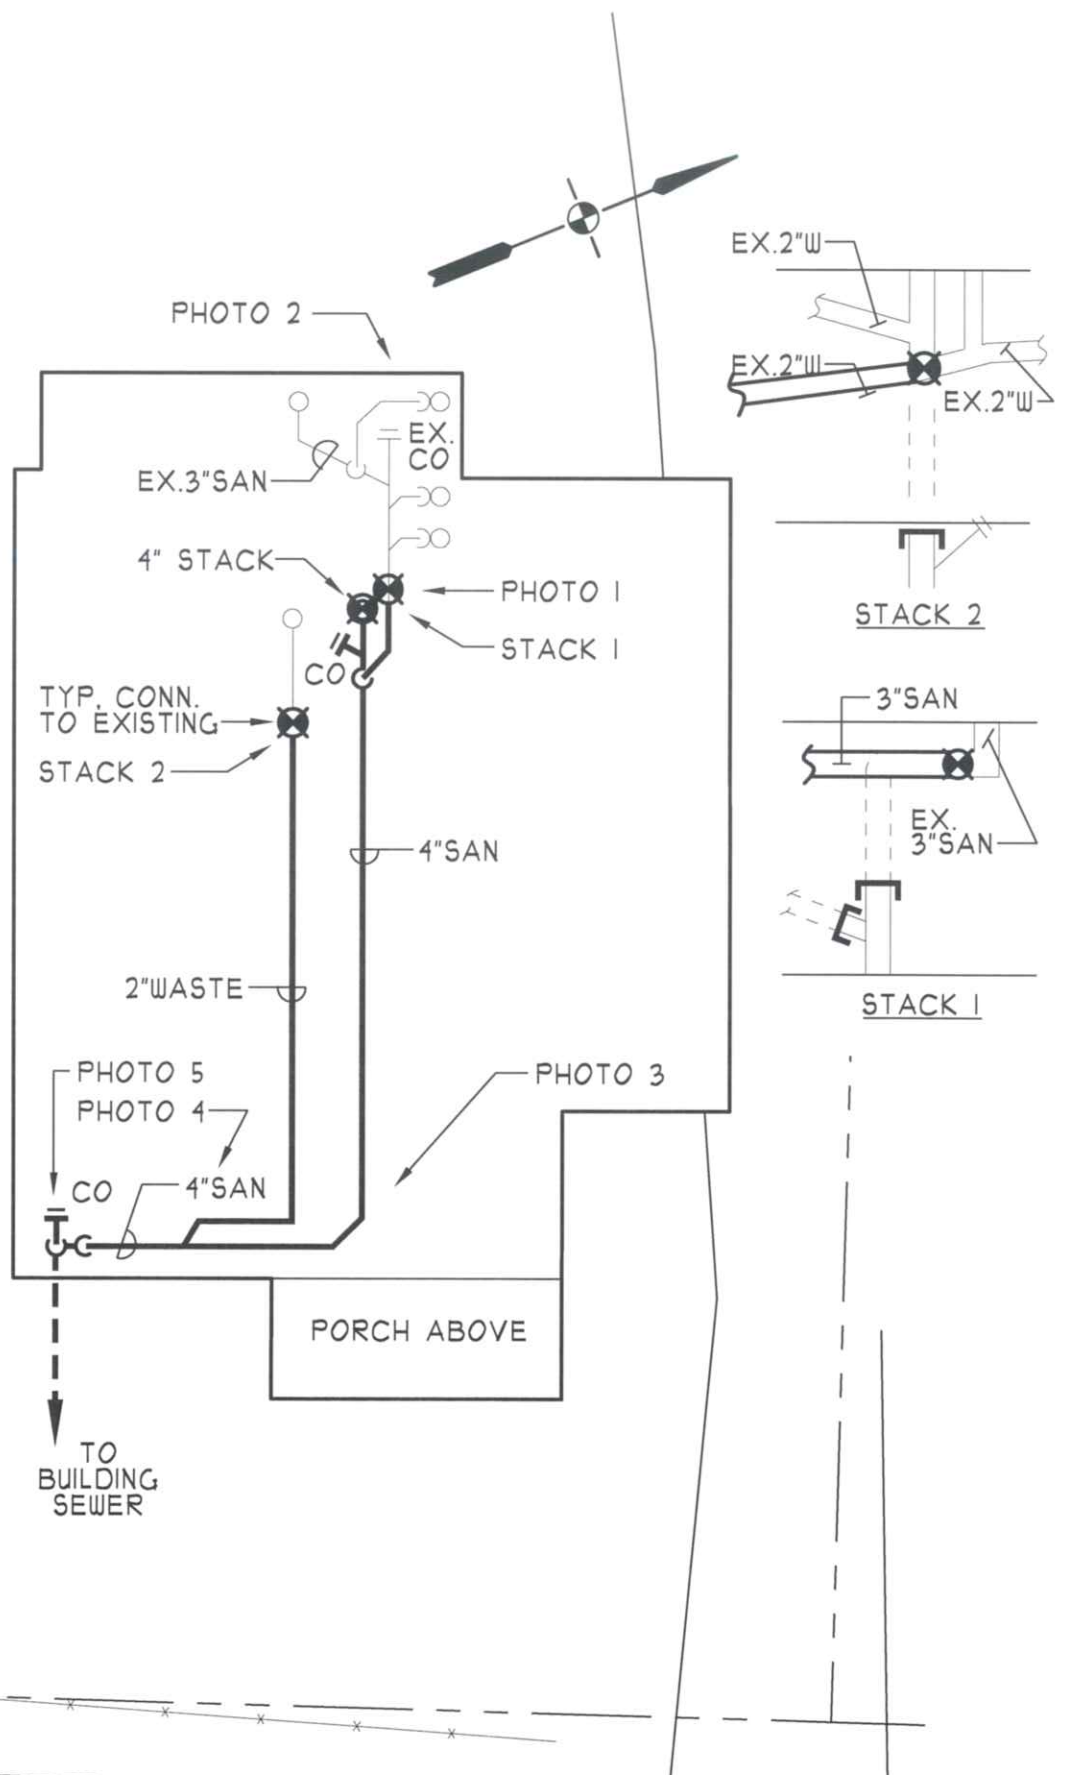

SCALE 1' = 10'

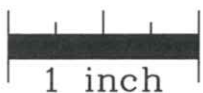

67
EDGEWOOD STREET
RAIN LEADER AND PLUMBING
REPORT INFORMATION

SOIL STACK No.1

- MATERIAL PVC CI GALV. OTHER
- HEIGHT TO BRANCH 5'-9"
- PHOTO 1
- SIZE 4"

SOIL STACK No.2

- MATERIAL PVC CI GALV. OTHER
- HEIGHT TO BRANCH 6'-5"
- PHOTO
- SIZE

FLOOR
TO
CEILING 7'-2"
FLOOR
JOIST
SIZE 9"