

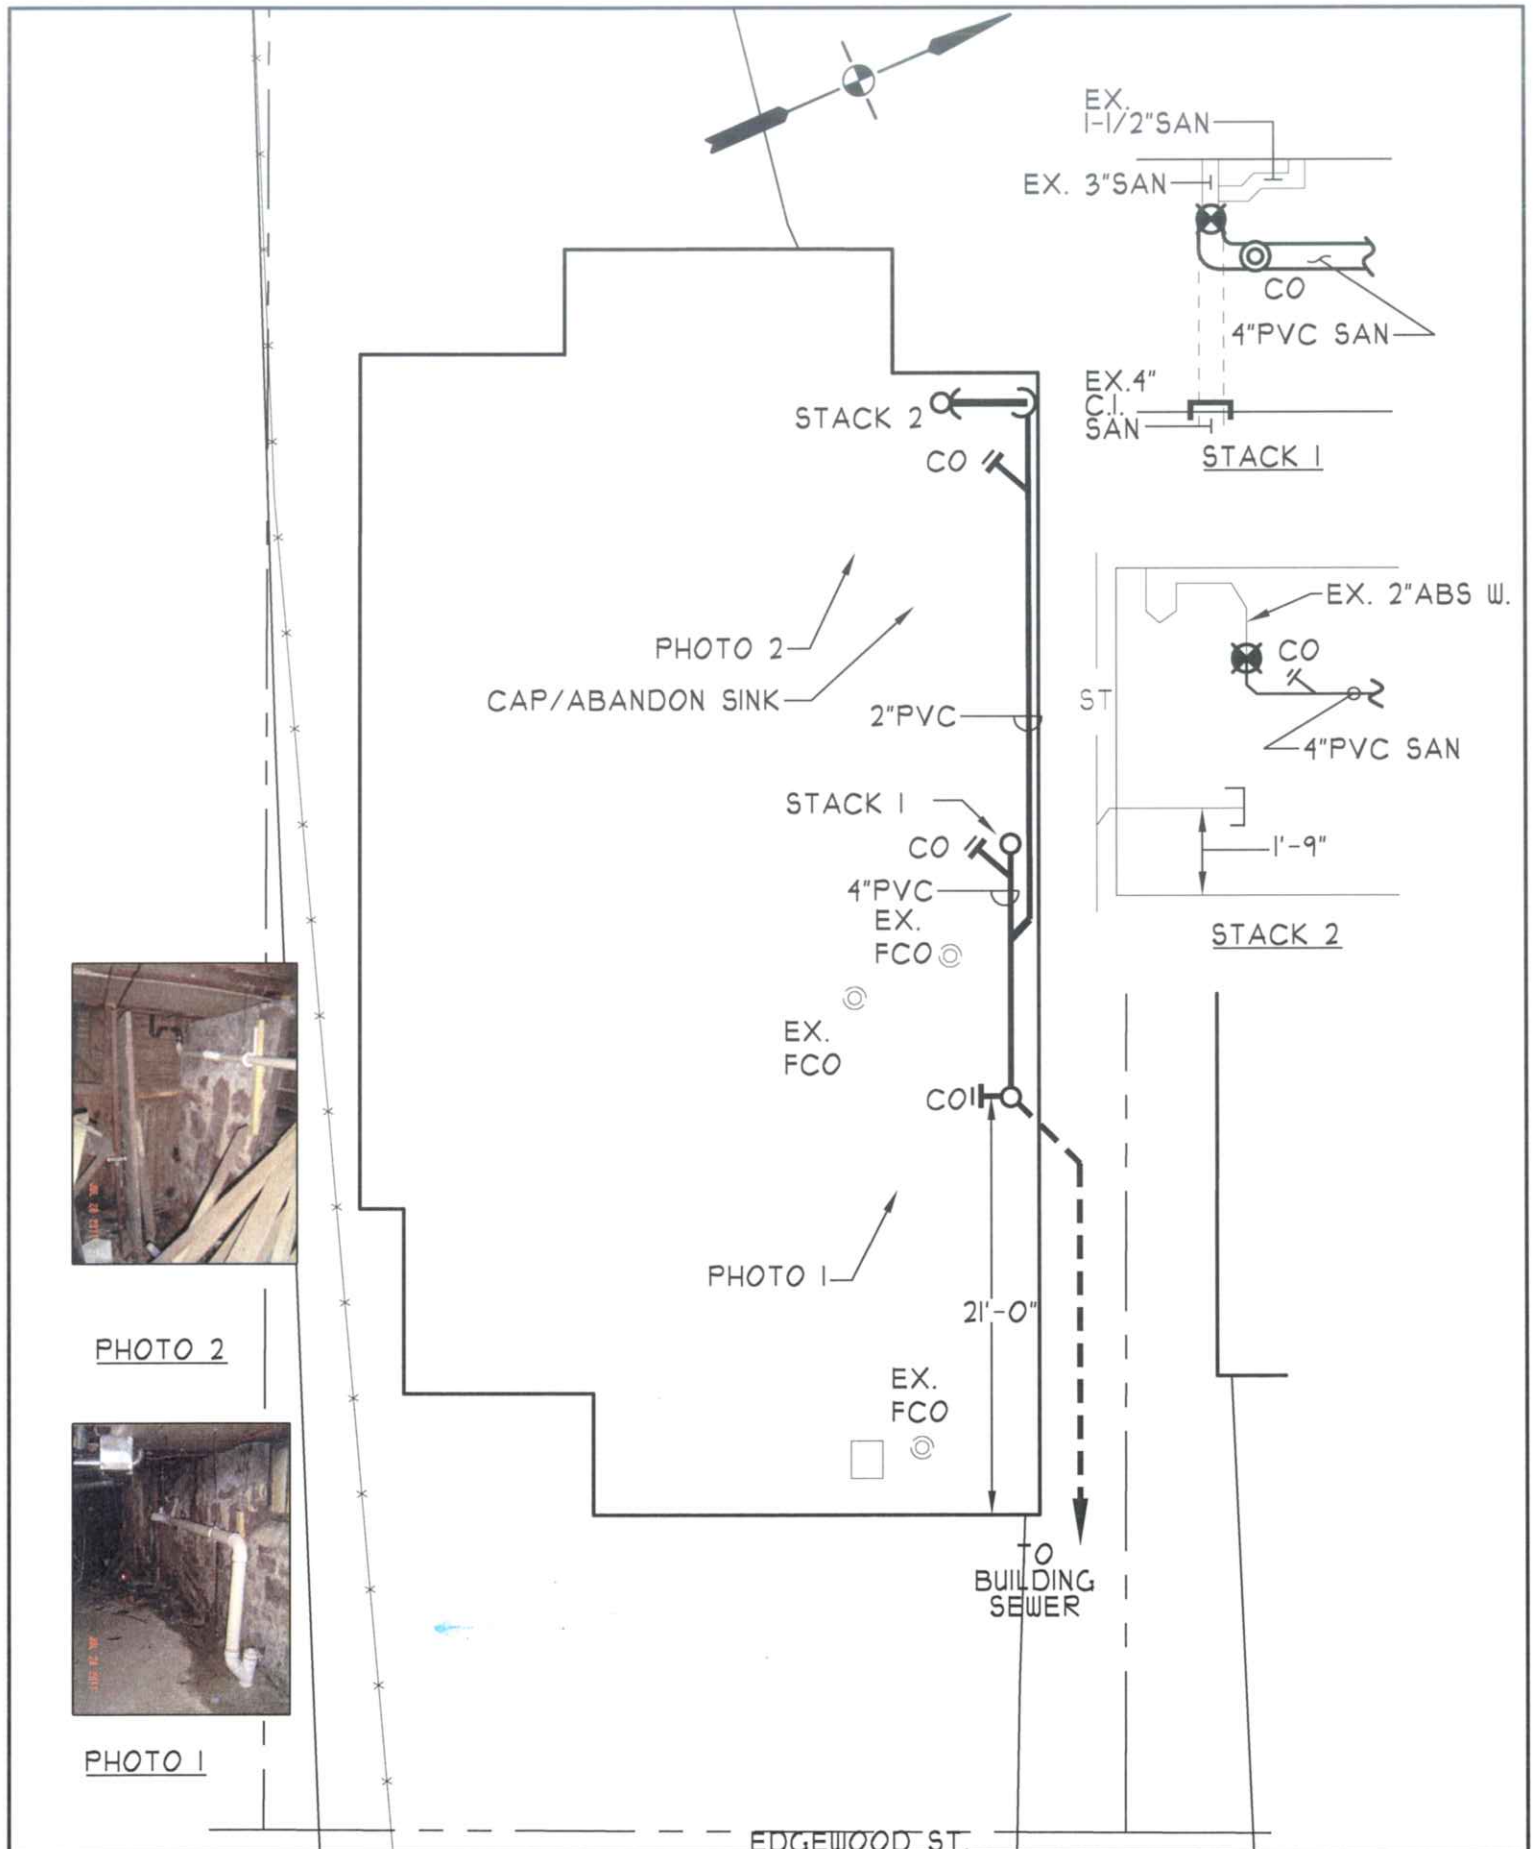


PHOTO 2



PHOTO 1

SCALE 1' = 10'



69-71
EDGEWOOD STREET
 RAIN LEADER AND PLUMBING
 REPORT INFORMATION

SOIL STACK No.1

- MATERIAL PVC CI GALV. OTHER
- HEIGHT TO BRANCH
- PHOTO
- SIZE 4"

SOIL STACK No.2

- MATERIAL PVC CI GALV. OTHER
- HEIGHT TO BRANCH
- PHOTO
- SIZE 2"

DATE: 7-28-11

JOIST SIZE 9"

FL. TO CLG 7'-6"