




PHOTO 3




PHOTO 2



PHOTO 1

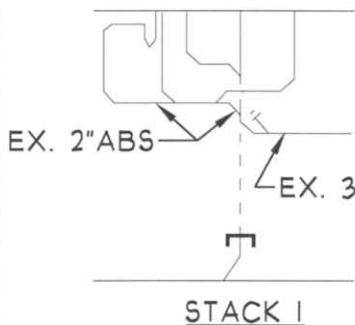


STACK 1

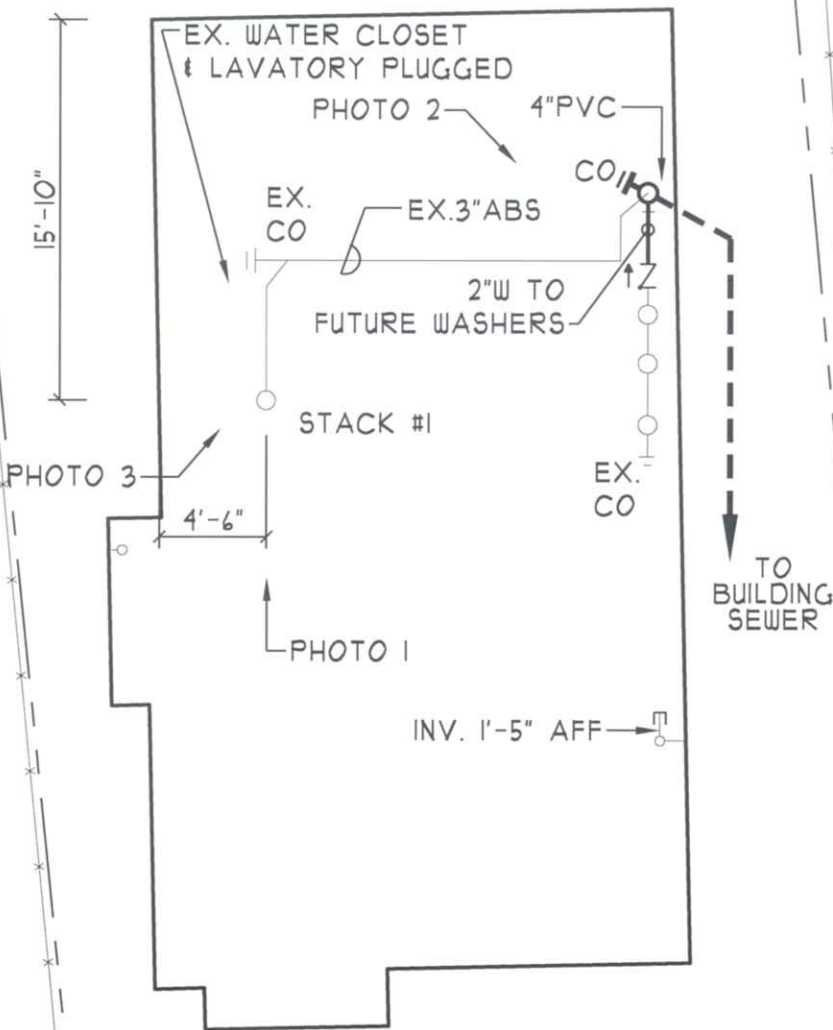

TO BUILDING SEWER

EDGEWOOD ST.

SCALE 1' = 10'

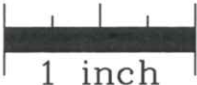

7-9
EDGEWOOD STREET
RAIN LEADER AND PLUMBING
REPORT INFORMATION

SOIL STACK No.1

- MATERIAL PVC CI GALV. OTHER _____
- HEIGHT TO BRANCH _____
- PHOTO _____
- SIZE _____

SOIL STACK No.2

- MATERIAL PVC CI GALV. OTHER _____
- HEIGHT TO BRANCH _____
- PHOTO _____
- SIZE _____

DATE: **8-17-11**

JOIST SIZE _____

FL. TO CLG _____