



PHOTO 2




PHOTO 3




PHOTO 4



PHOTO 5

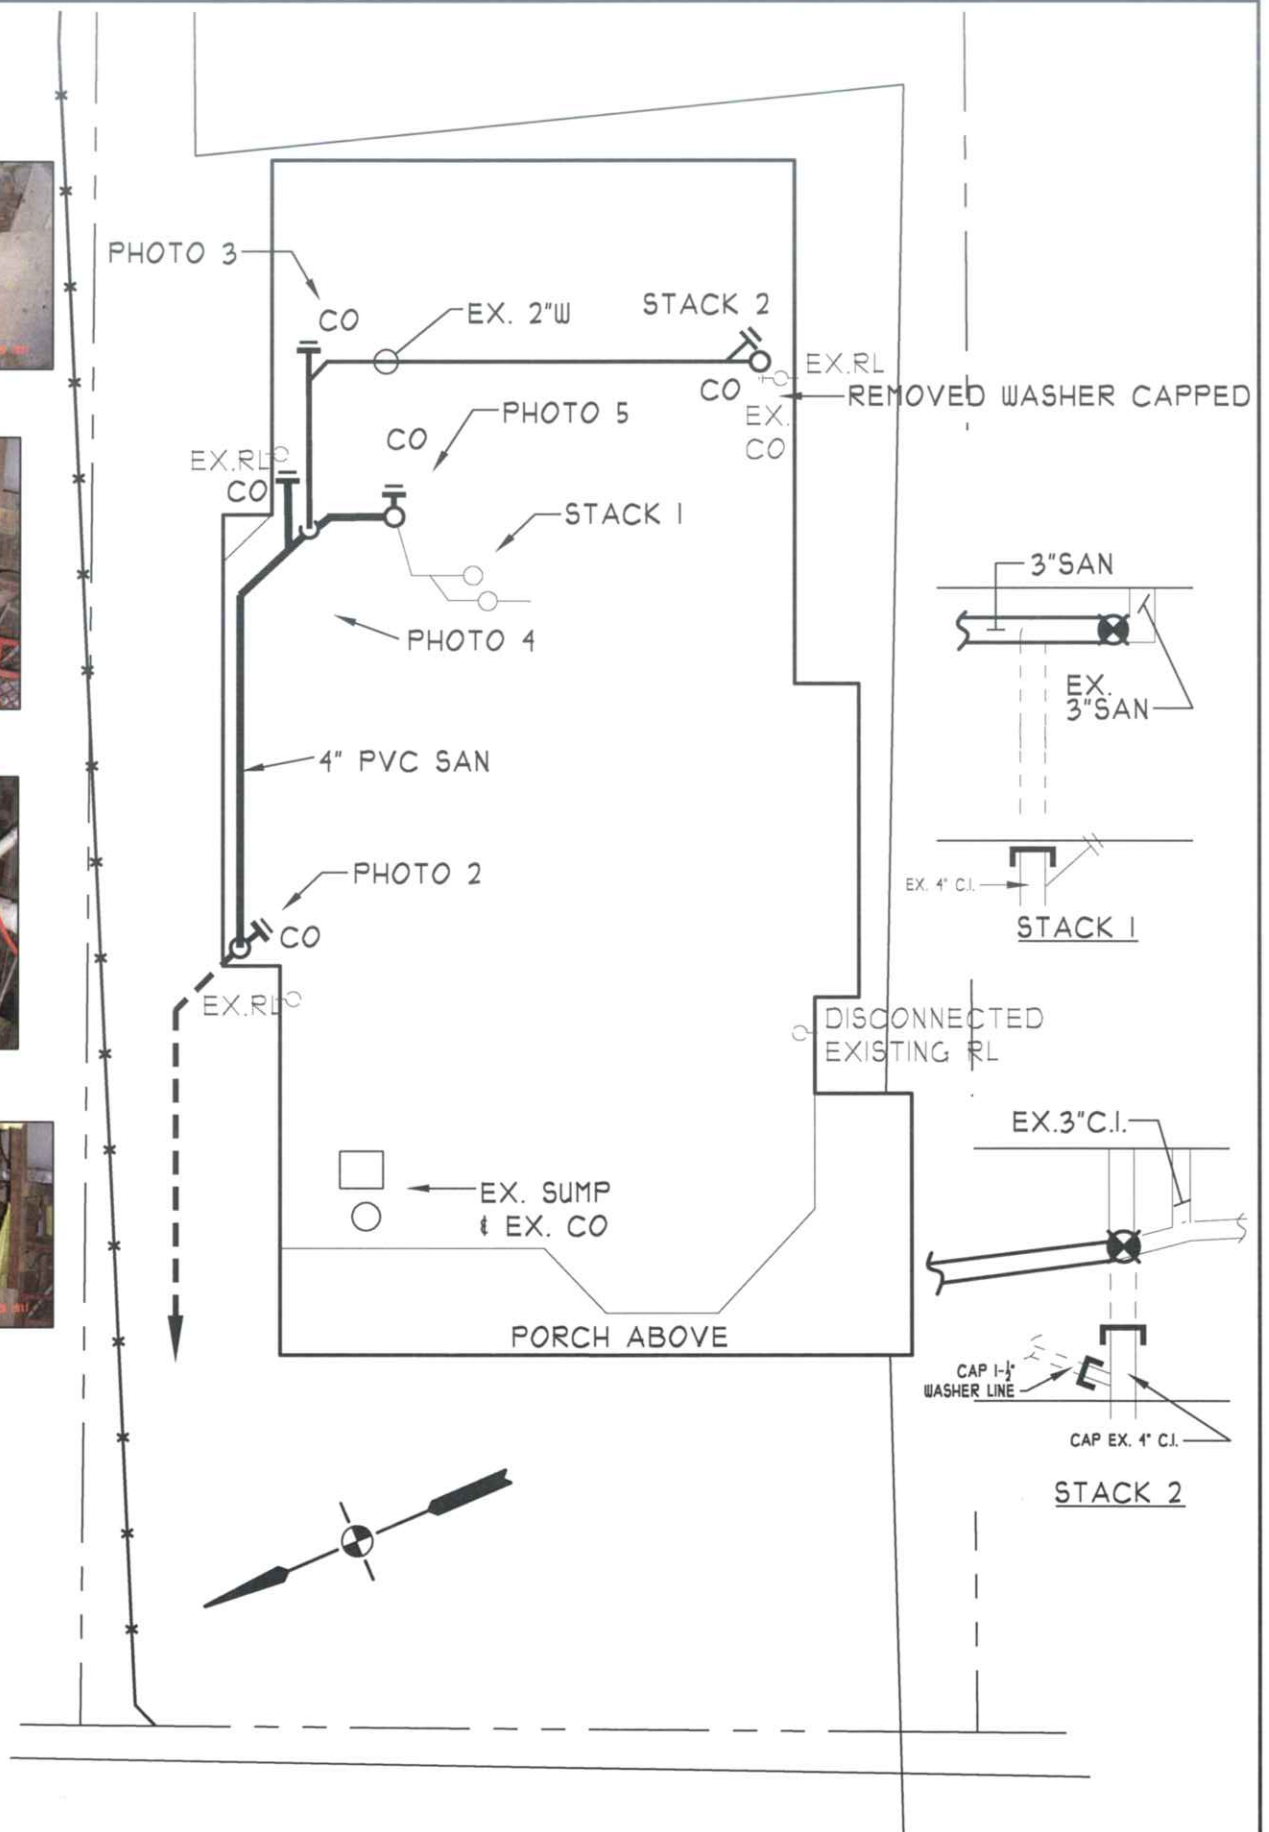

SCALE 1' = 10'

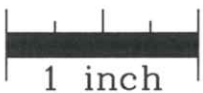

**70-72
EDGEWOOD STREET**
RAIN LEADER AND PLUMBING
REPORT INFORMATION

SOIL STACK No.1

- MATERIAL PVC ☒ GALV. ☐ OTHER ☐
- HEIGHT TO BRANCH 1'-0"
- PHOTO 1
- SIZE 4"

SOIL STACK No.2

- MATERIAL PVC ☒ GALV. ☐ OTHER ☐
- HEIGHT TO BRANCH 4'-1"
- PHOTO 2
- SIZE 3"

FLOOR TO CEILING	<u>7'-6"</u>
FLOOR	<u>N-5</u>
JOIST SIZE	<u>9"</u>