



PHOTO 1




PHOTO 2



PHOTO 3



PHOTO 4

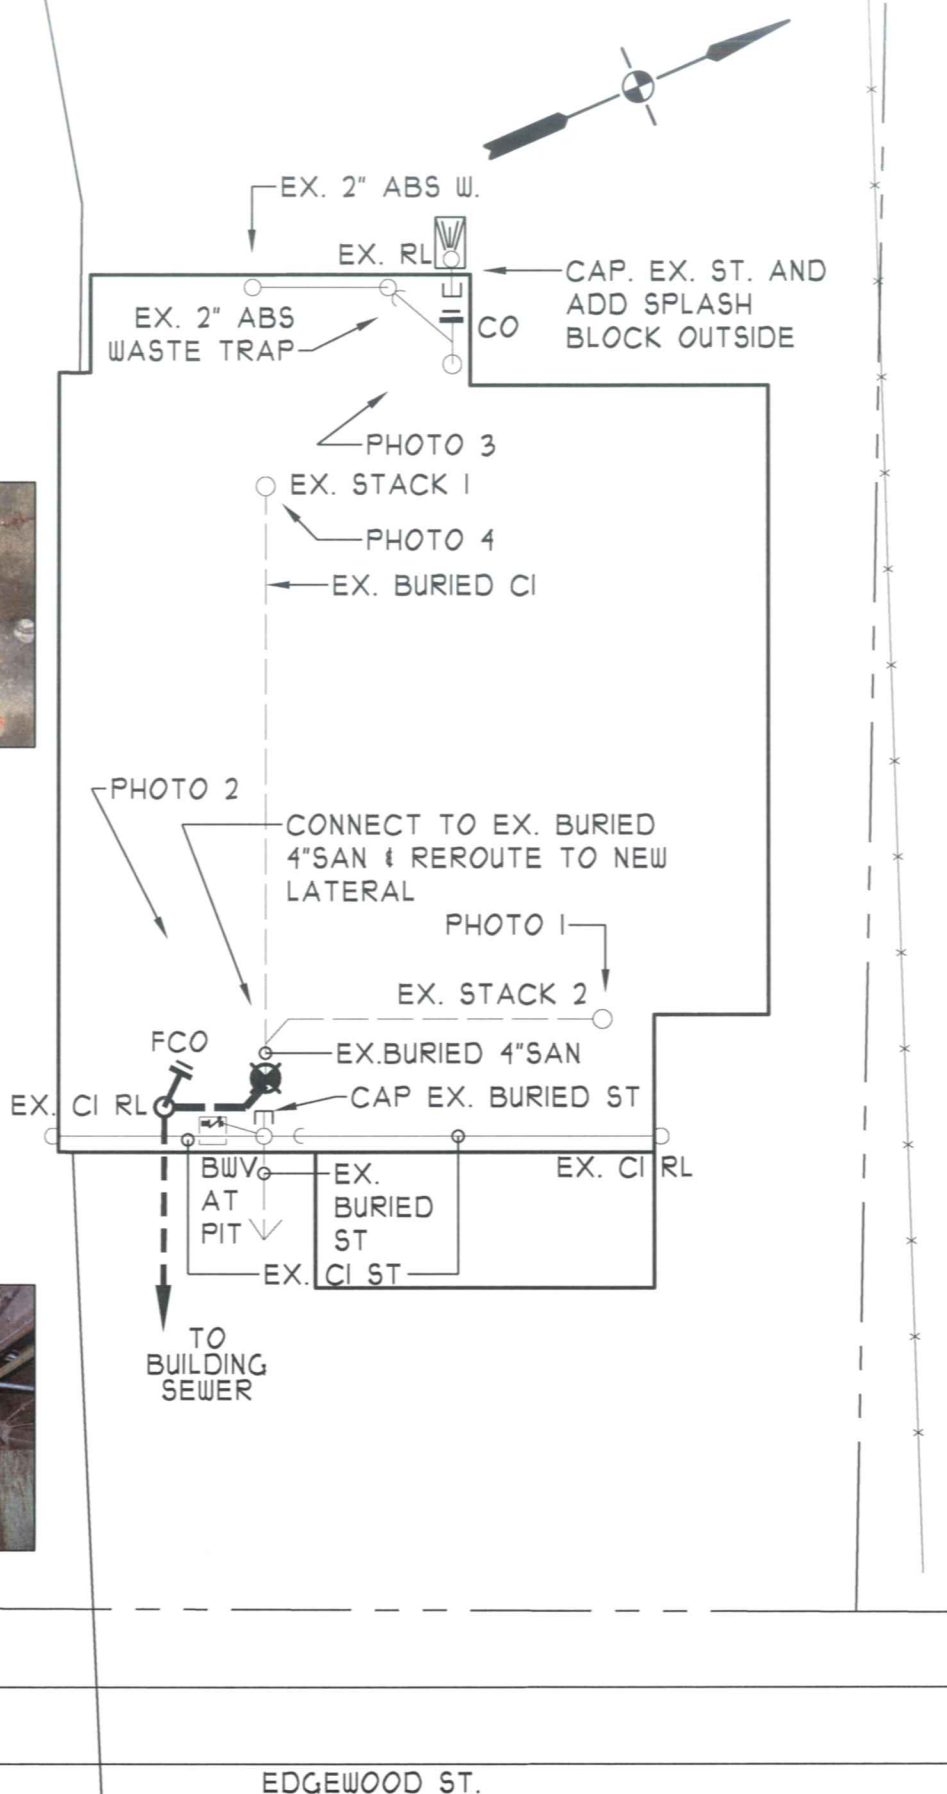

EDGEWOOD ST.

SCALE 1' = 10'

1 inch

73-75
EDGEWOOD STREET
 RAIN LEADER AND PLUMBING
 REPORT INFORMATION

SOIL STACK No.1

- MATERIAL PVC (C) GALV. OTHER
- HEIGHT TO BRANCH 6'-6"
- PHOTO 4
- SIZE 4"

SOIL STACK No.2

- MATERIAL PVC (C) GALV. OTHER
- HEIGHT TO BRANCH 5'-0"
- PHOTO 1
- SIZE 4"

DATE: 8-19-11

JOIST SIZE 9"

FL. TO CLG 1'-0"