






PHOTO 1



PHOTO 2




PHOTO 3

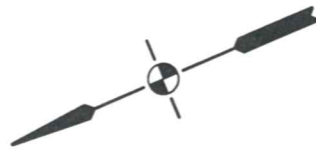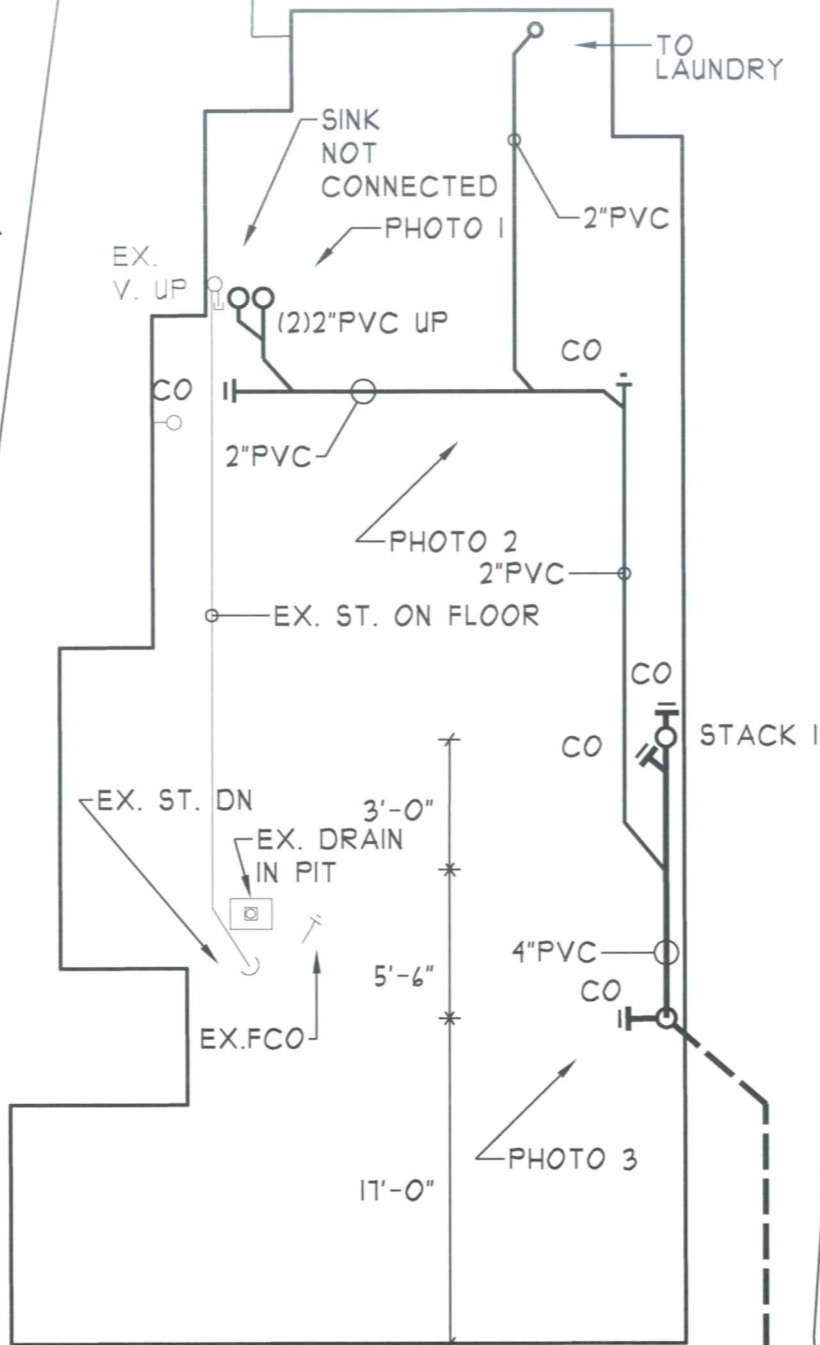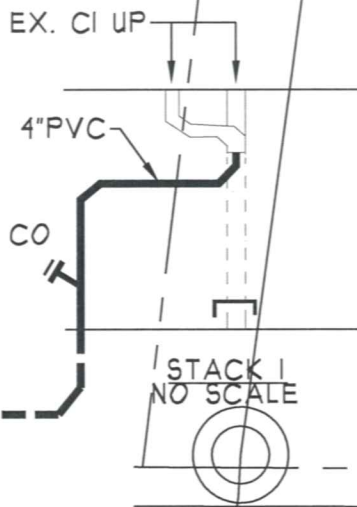

EDGEWOOD

SCALE 1' = 10'

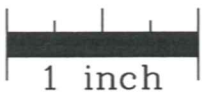

**78-80
EDGEWOOD STREET**
RAIN LEADER AND PLUMBING
REPORT INFORMATION

SOIL STACK No.1

- MATERIAL PVC CI GALV. OTHER _____
- HEIGHT TO BRANCH _____
- PHOTO _____
- SIZE _____

SOIL STACK No.2

- MATERIAL PVC CI GALV. OTHER _____
- HEIGHT TO BRANCH _____
- PHOTO _____
- SIZE _____

DATE: **7-28-11**

JOIST SIZE _____

FL. TO CLG _____