



PHOTO 1

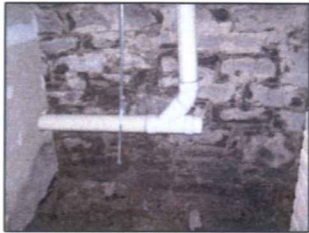


PHOTO 2





PHOTO 3




PHOTO 4



PHOTO 5

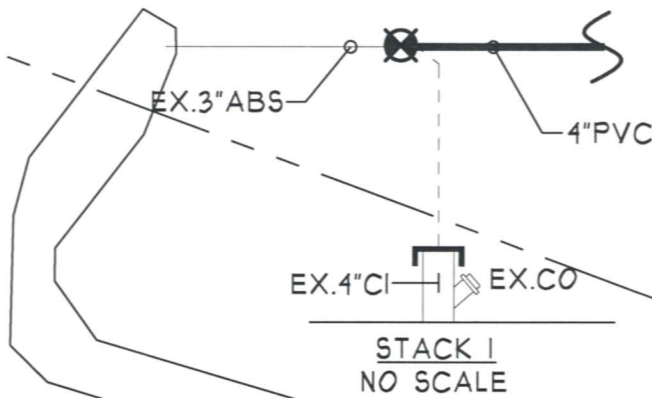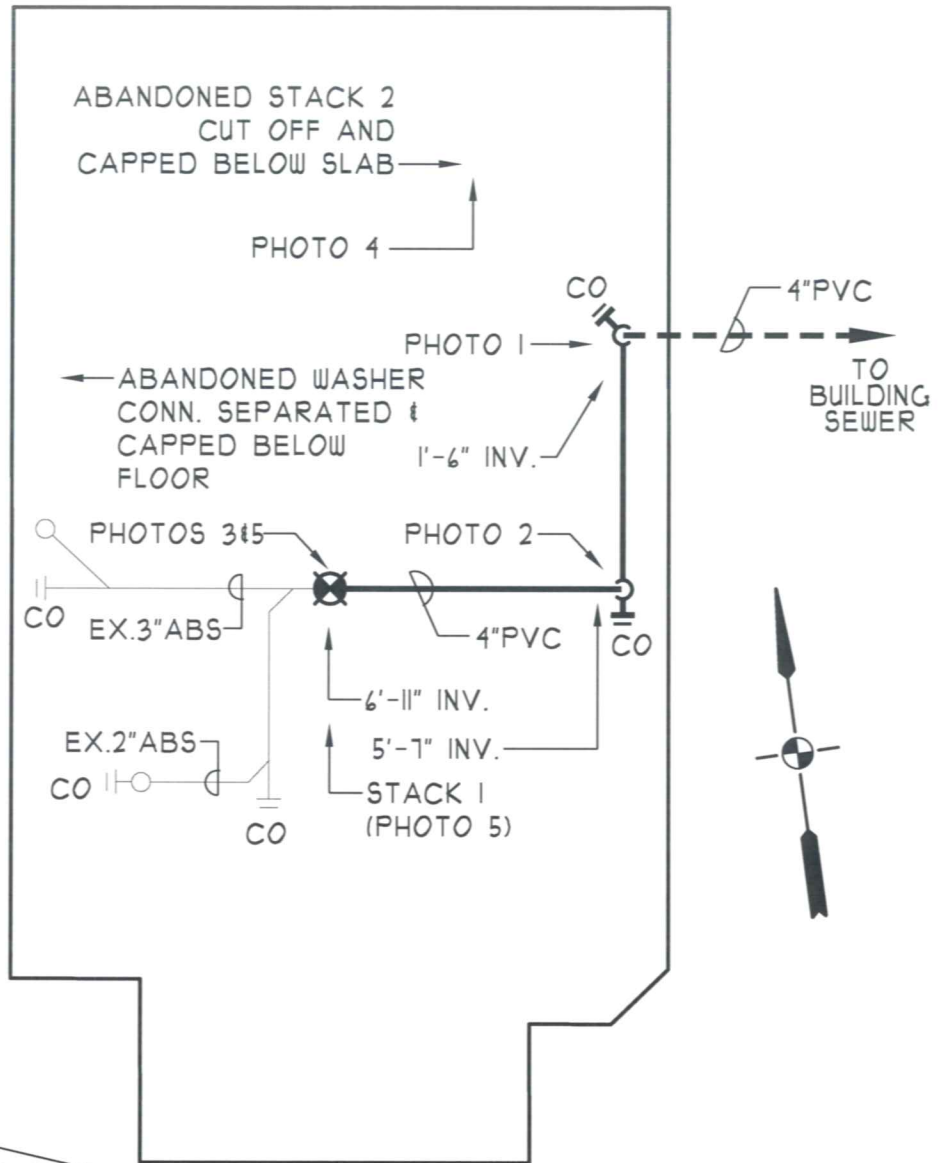

SCALE 1' = 10'

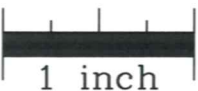

**890-896
ALBANY AVE**

RAIN LEADER AND PLUMBING
REPORT INFORMATION

SOIL STACK No.1

- MATERIAL PVC CI GALV. OTHER _____
- HEIGHT TO BRANCH _____
- PHOTO _____
- SIZE _____

SOIL STACK No.2

- MATERIAL PVC CI GALV. OTHER _____
- HEIGHT TO BRANCH _____
- PHOTO _____
- SIZE _____

DATE: **8-4-11**

JOIST SIZE _____

FL. TO CLG _____